

19. S. BELMONT AS-BUILTS

FLOOR PLANS

19 SOUTH BELMONT AVENUE
RICHMOND, VIRGINIA 23221

DRAWN BY DSM

DESIGNED BY -

CHECKED BY -

DATE 04-22-15


SCALE -

REVISIONS:


SHEET NO.

A1.1


JOB NO. 53150025.00

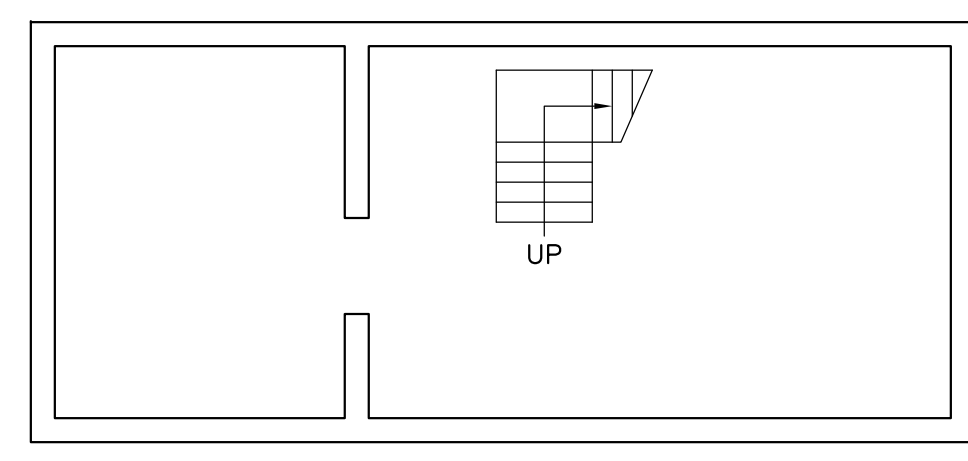

1 BASEMENT PLAN (567 SF)
SCALE = 1/8"=1'-0"

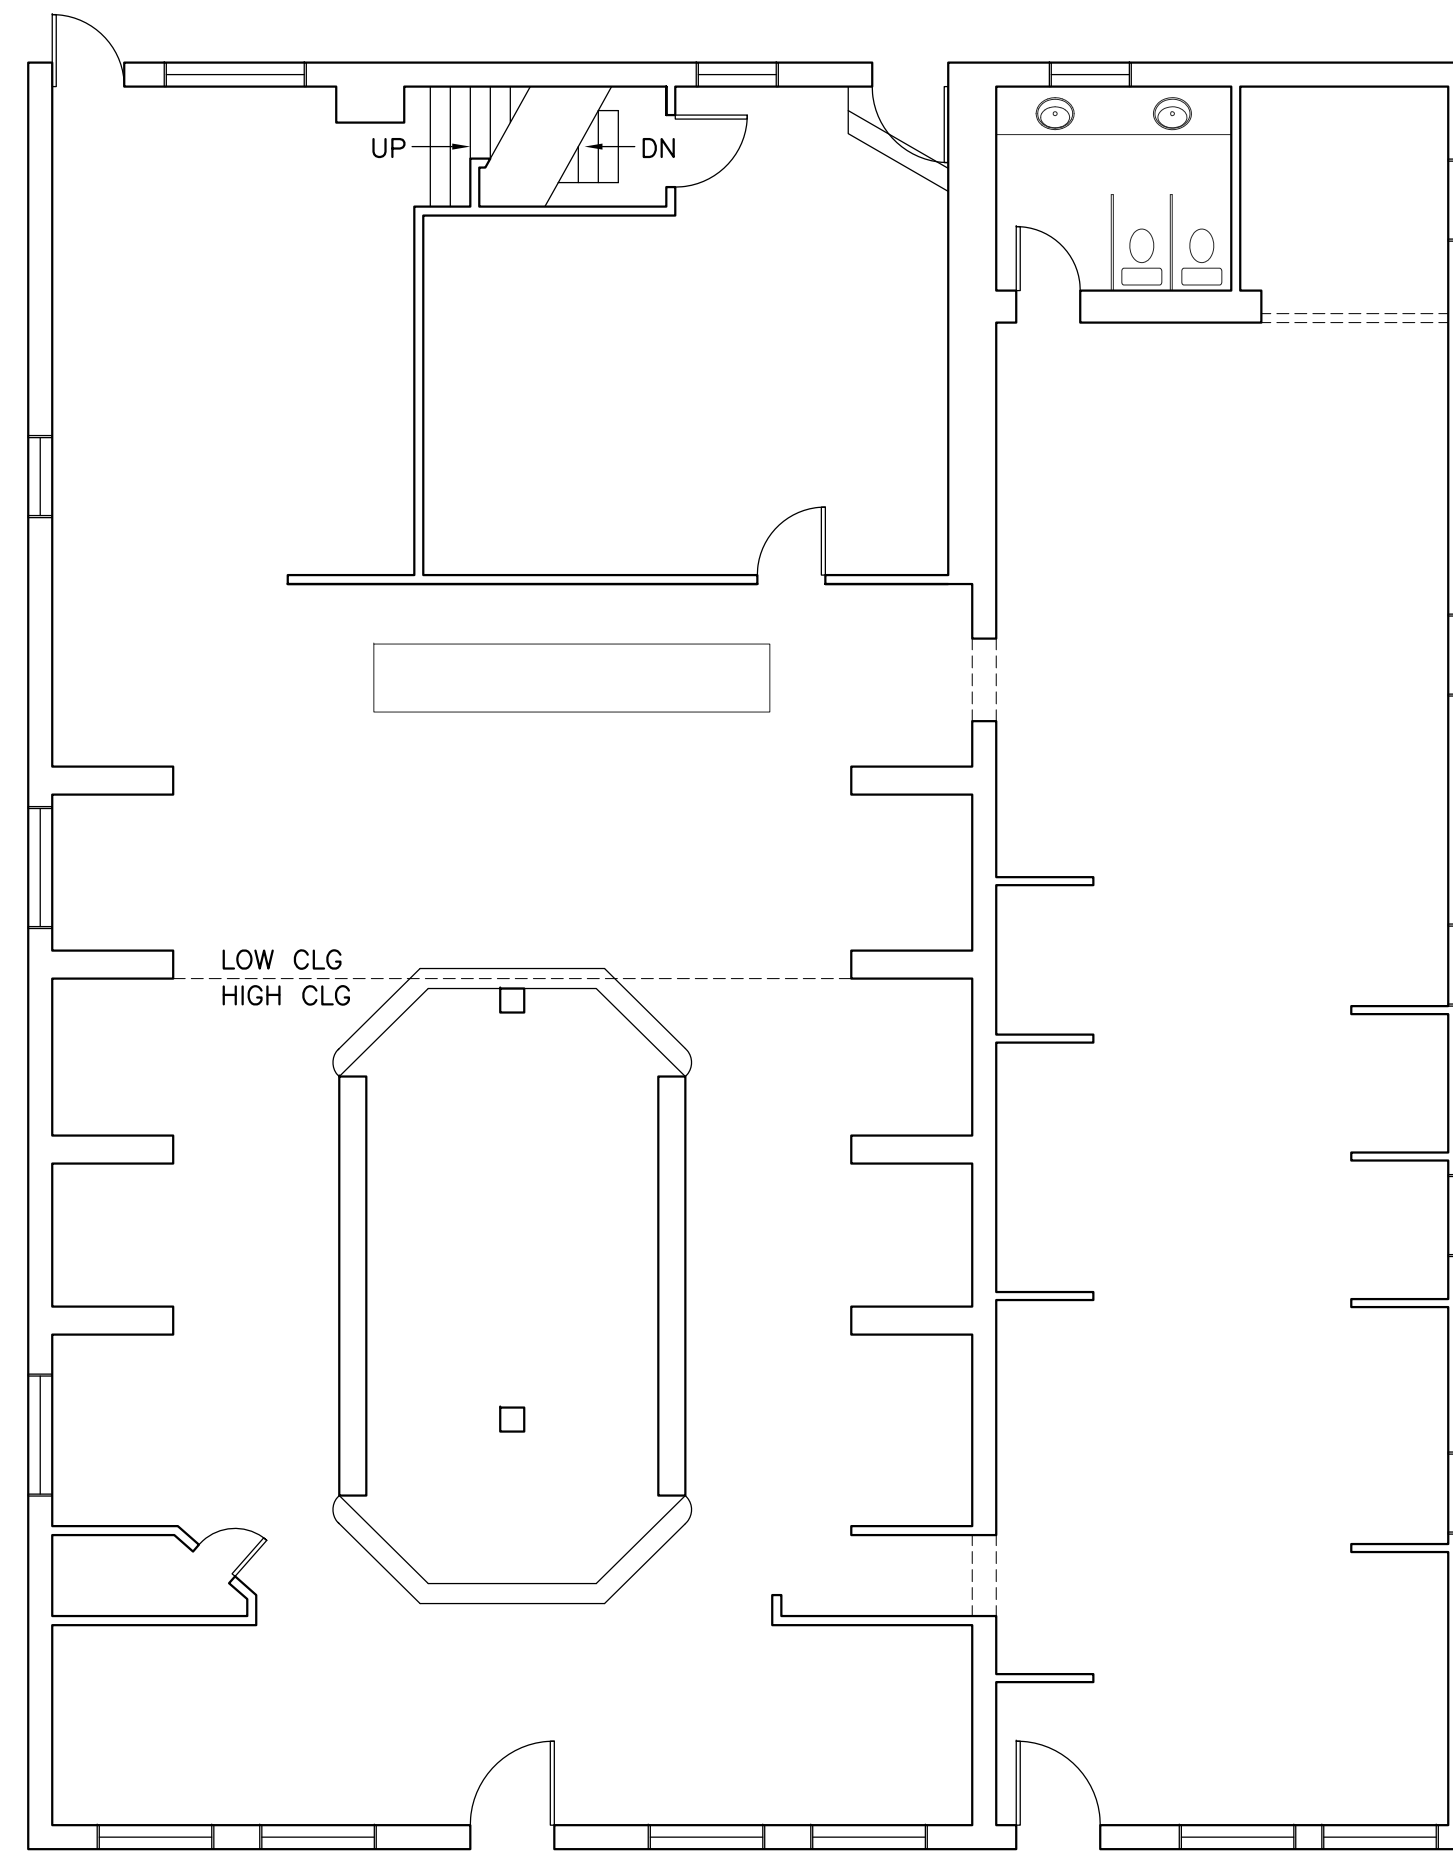

2 FIRST FLOOR PLAN (4,120 SF)
SCALE = 1/8"=1'-0"

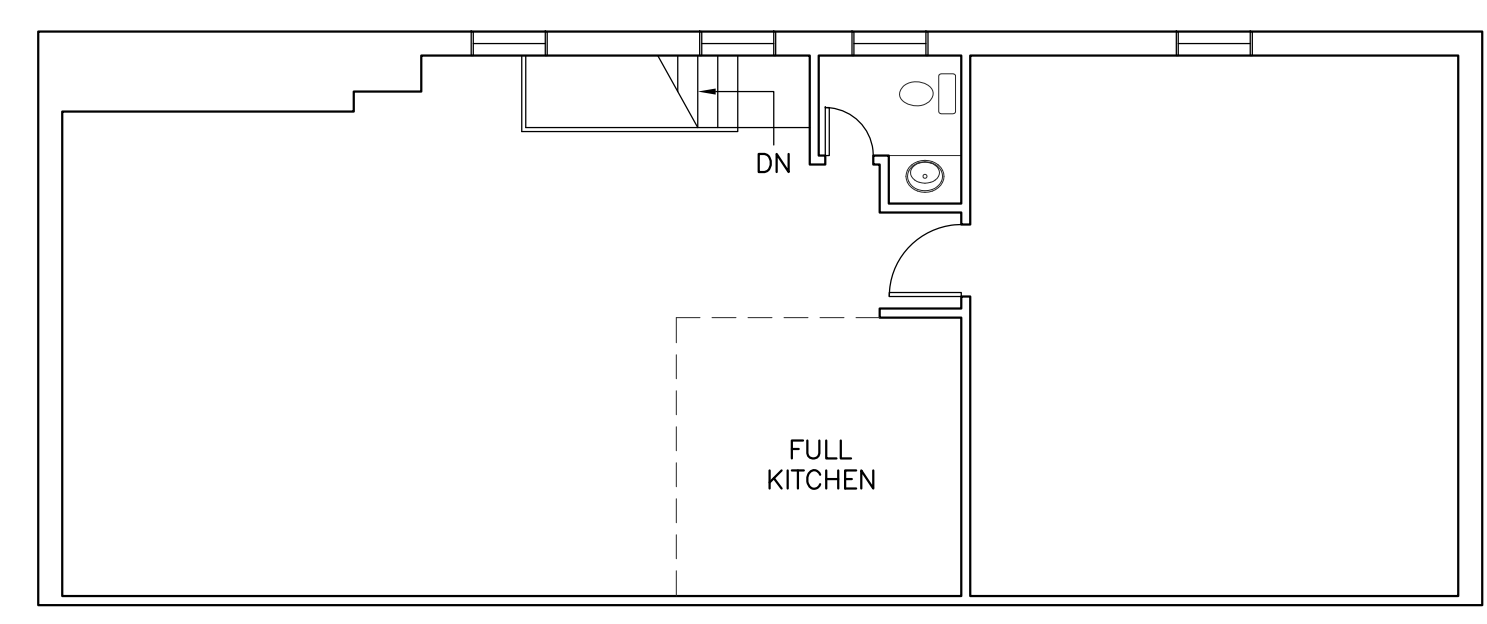

3 SECOND FLOOR PLAN (1,277 SF)
SCALE = 1/8"=1'-0"

5,964 SF TOTAL