



"EXHIBIT A" - PAGE 1 OF 4

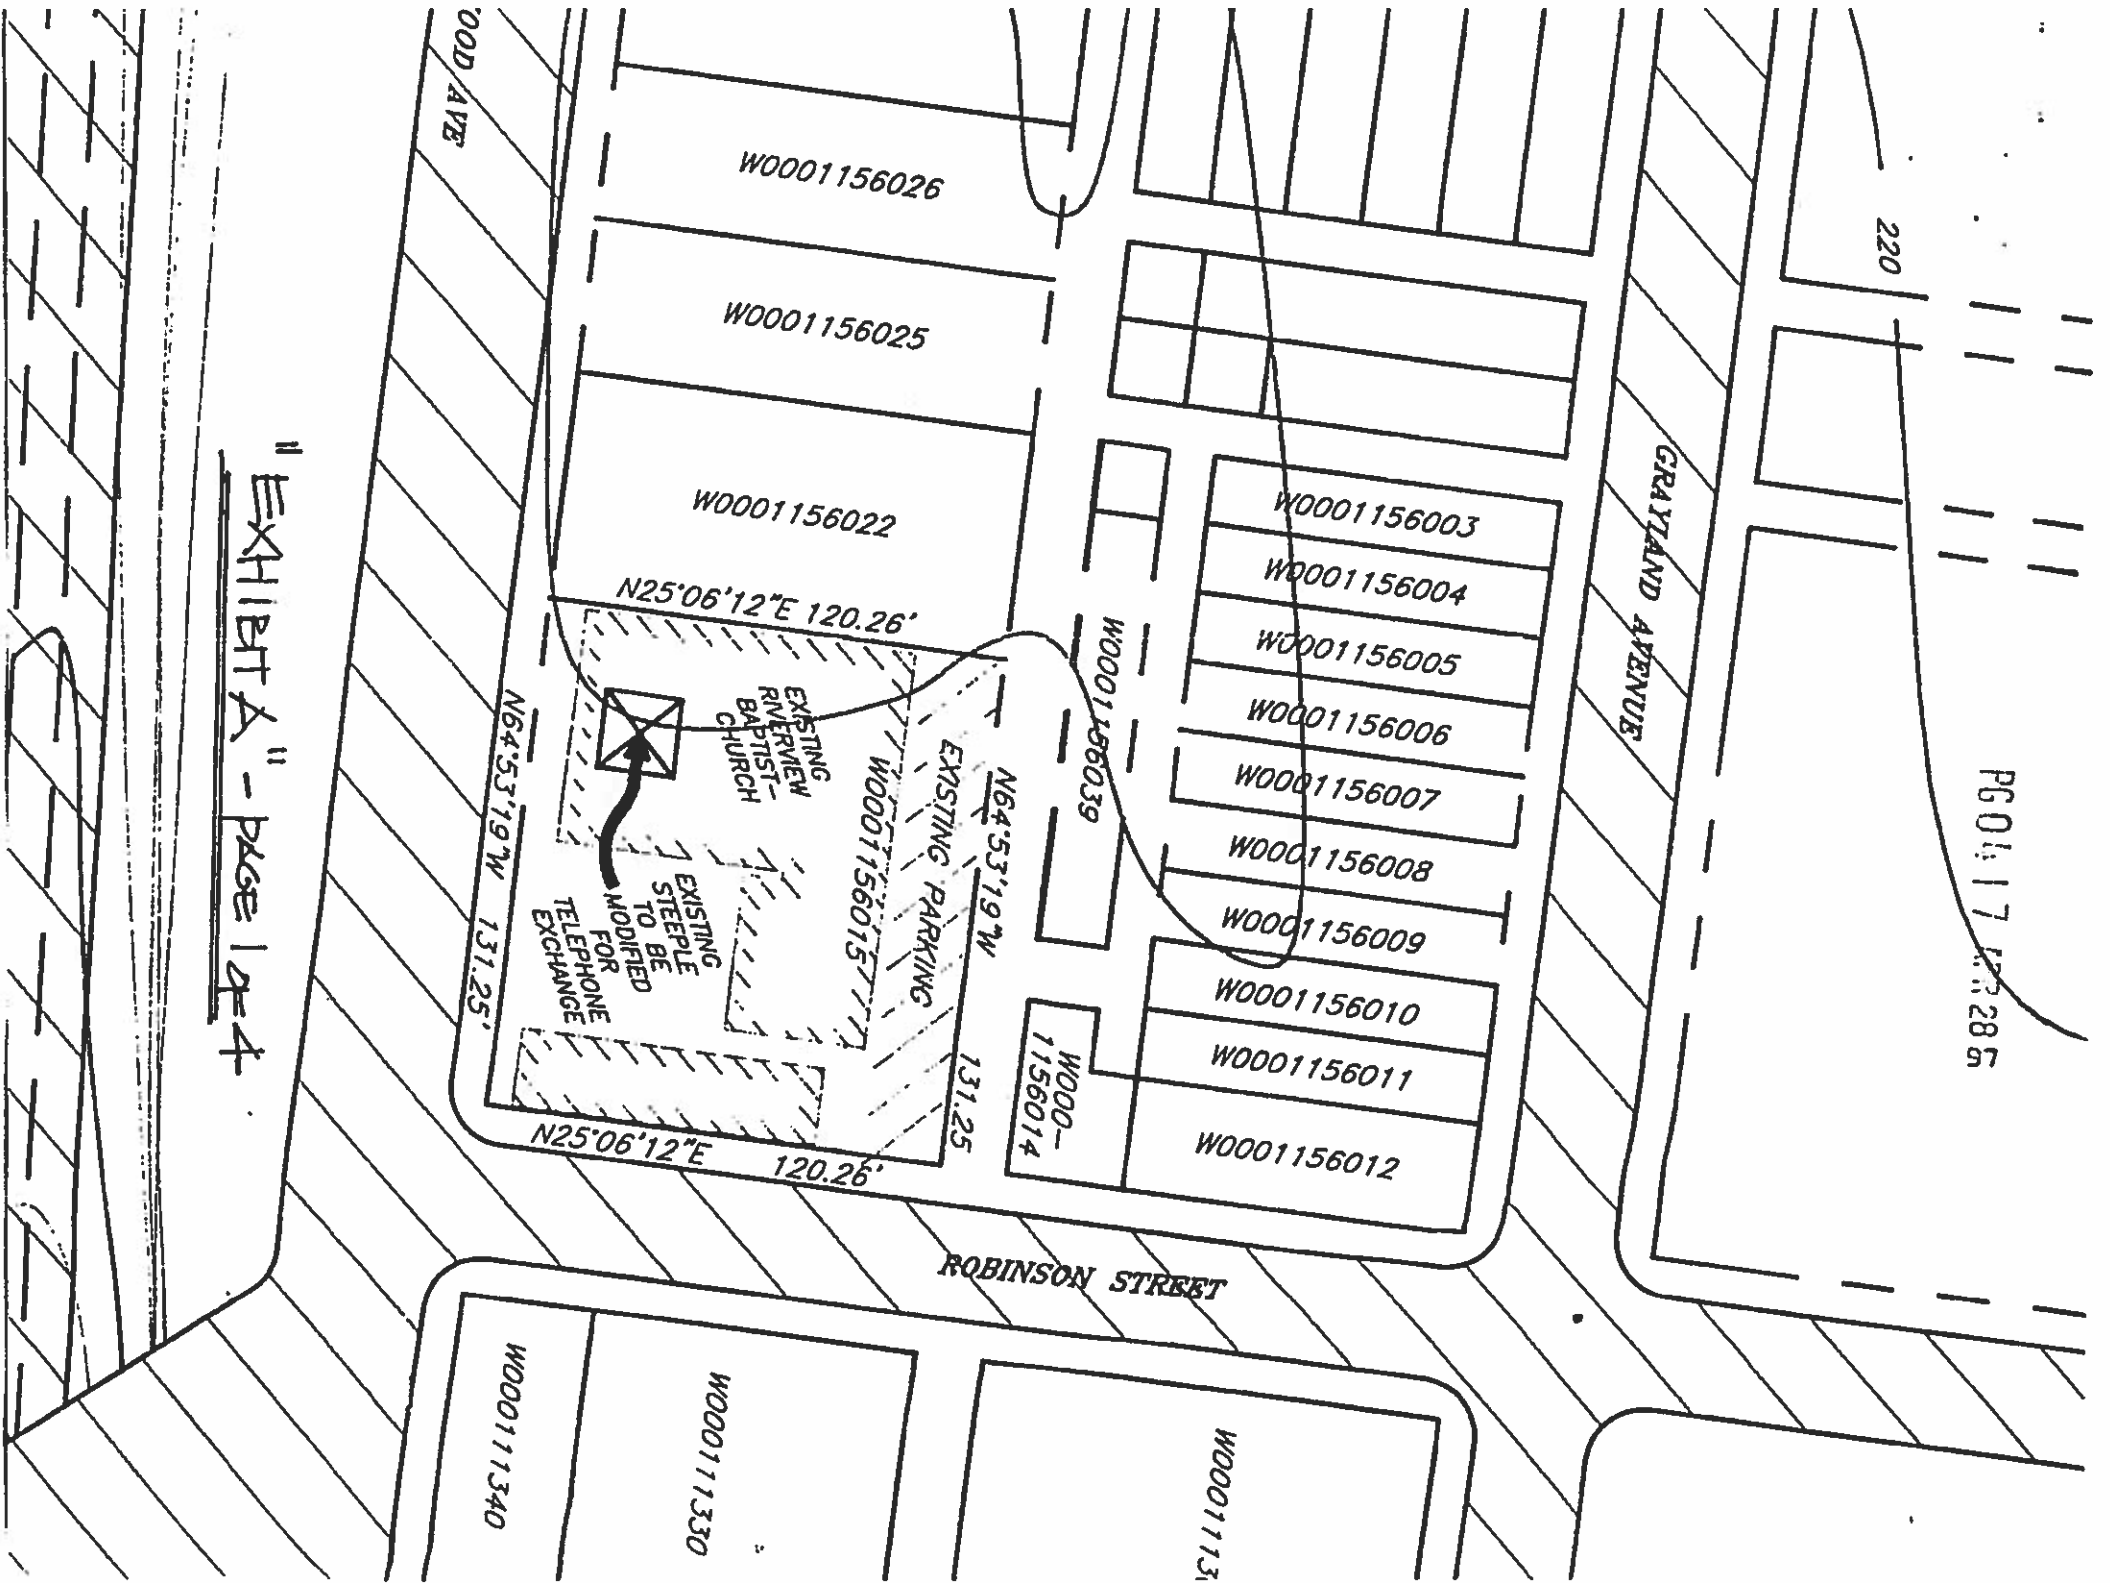


PG 0117 APR 28 6

Handwritten note: Building for the...
5/11/2017

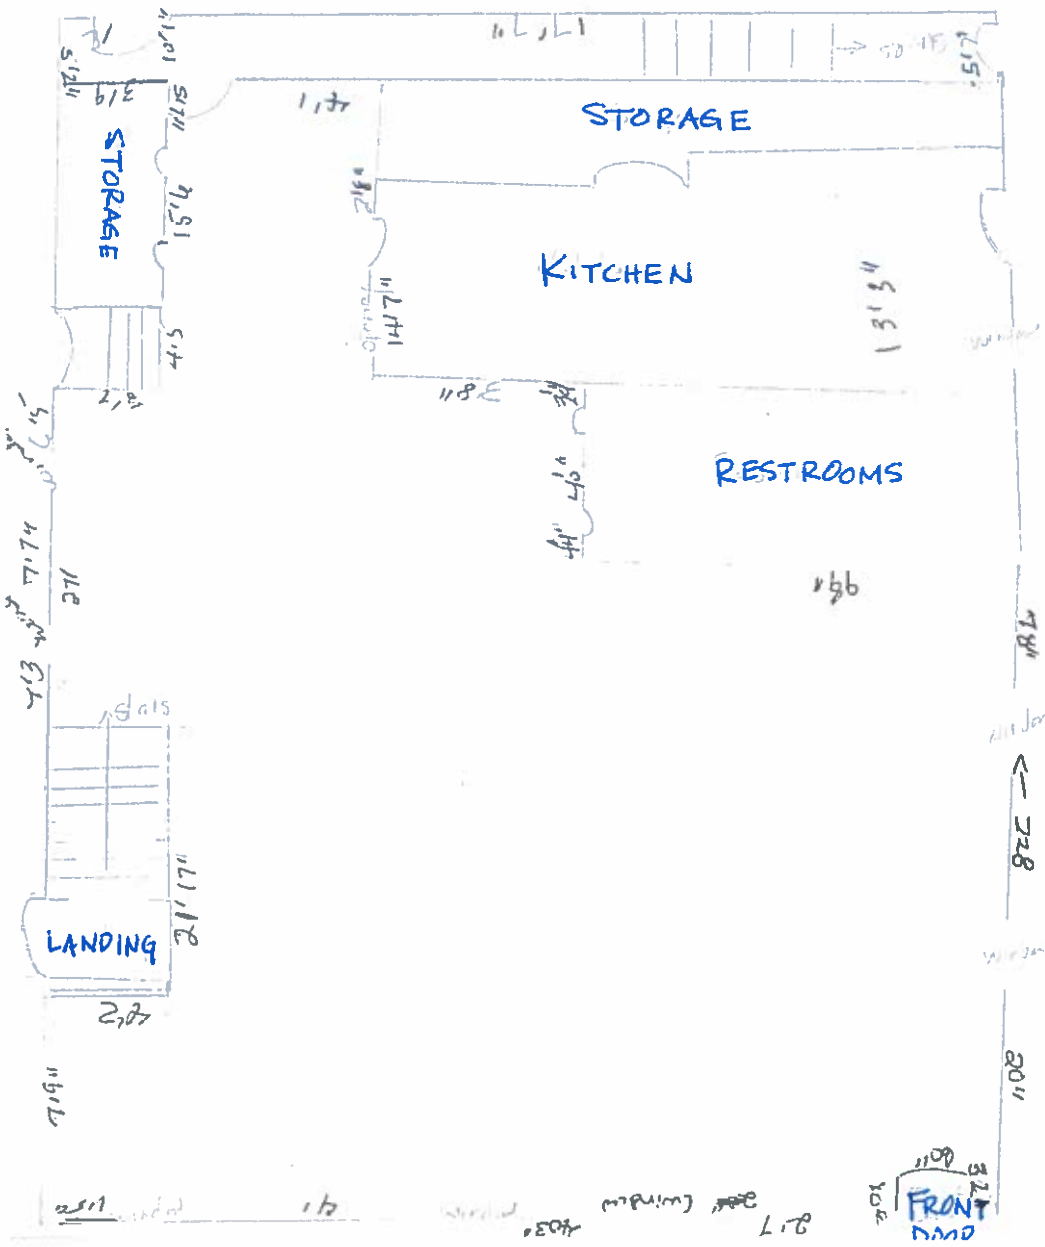

Window 3'2"
Door 2'2"

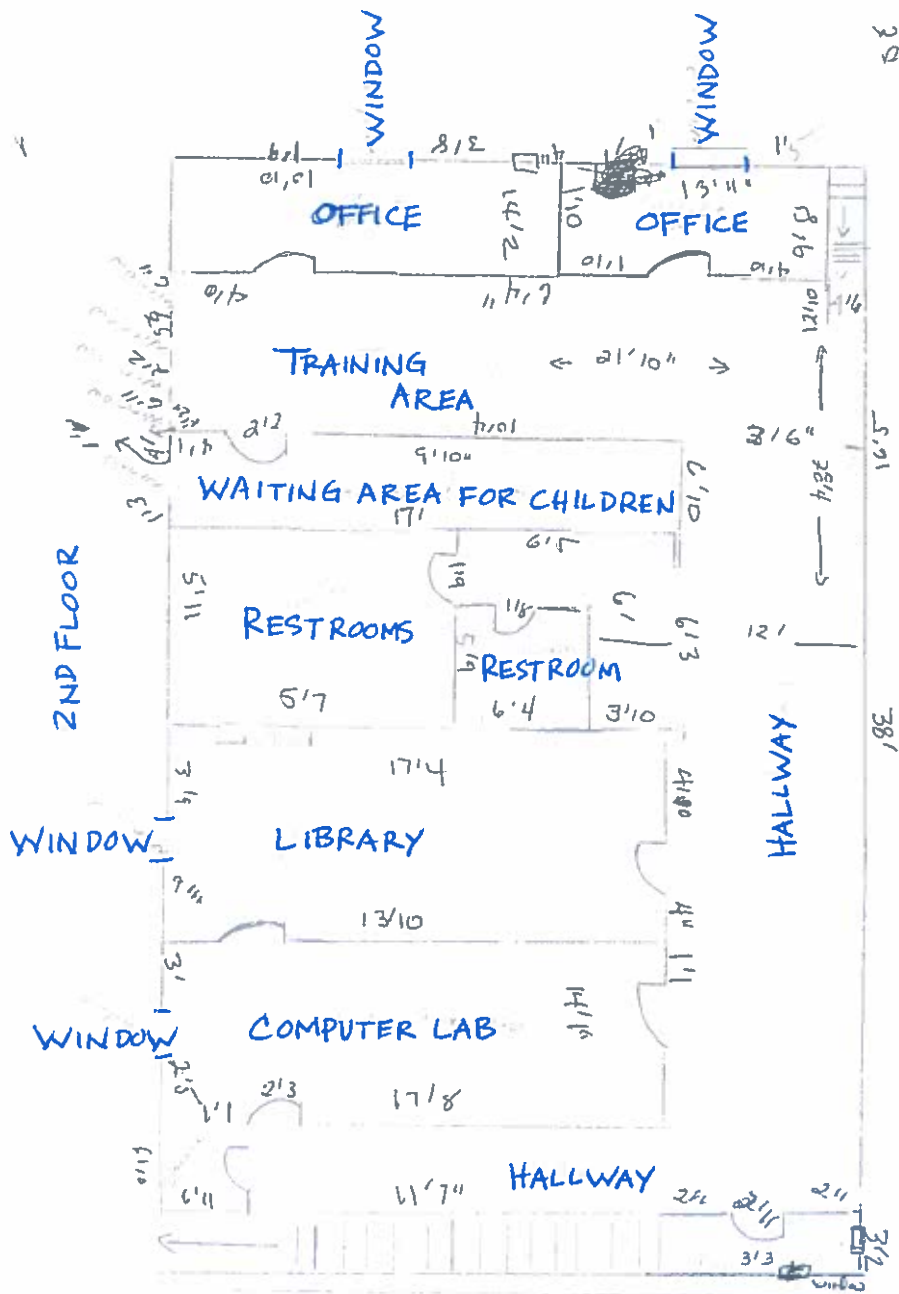

Handwritten signature and date in red ink: 5/14/17

2nd Floor
Drawn by: Carol Ann
Date: 5/11/2015
Page: 2 of 2