



DEPARTMENT OF
**PLANNING AND
DEVELOPMENT
REVIEW**

Commission of Architectural Review
Certificate of Appropriateness Application
900 E. Broad Street, Room 510
Richmond, VA 23219
804-646-6569

Property *(location of work)*

Property Address: 411 Chimborazo Boulevard Current Zoning: R-8
Historic District: Chimborazo Park

Application is submitted for: (check one)

- Alteration
- Demolition
- New Construction

Project Description *(attach additional sheets if needed):*

Revision to June 2025 CAR Approval - enclosure of proposed porch
Previously approved: Construction of a two story addition to the rear of an existing single family home.

Applicant/Contact Person: Andy Scudder

Company: Johannas Design Group
Mailing Address: [REDACTED]
City: Richmond State: VA Zip Code: 23220
Telephone: [REDACTED]
Email: [REDACTED]
Billing Contact? No Applicant Type (owner, architect, etc.): Architect

Property Owner: Charles Hall and Suzanne Giunta

If Business Entity, name and title of authorized signee: _____
Mailing Address: [REDACTED]
City: Richmond State: VA Zip Code: 23223
Telephone: [REDACTED]
Email: [REDACTED]
Billing Contact? Yes

****Owner must sign at the bottom of this page****

Acknowledgement of Responsibility

Compliance: If granted, you agree to comply with all conditions of the certificate of appropriateness (COA). Revisions to approved work require staff review and may require a new application and approval from the Commission of Architectural Review (CAR). Failure to comply with the conditions of the COA may result in project delays or legal action. The COA is valid for one (1) year and may be extended for an additional year, upon written request and payment of associated fee.

Requirements: A complete application includes all applicable information requested on checklists available on the CAR website to provide a complete and accurate description of existing and proposed conditions, as well as payments of the application fee. Applications proposing major new construction, including additions, should meet with staff to review the application and requirements prior to submitting. Owner contact information and signature is required. Late or incomplete applications will not be considered.

Zoning Requirements: Prior to Commission review, it is the responsibility of the applicant to determine if zoning approval is required. Application materials should be prepared in compliance with zoning.

Property Owner Signature: [REDACTED] Date: February 2, 2026



411 Chimborazo Boulevard

City Old & Historic District: Chimborazo Park

JOHANNAS design group
1901 West Cary Street
Richmond Virginia 23220

P. 804.358.4993

F. 804.358.8211

W. johannasdesign.com

This single family detached house is located in the Chimborazo Park O&H district and is zoned R-8. Originally built in 1898, it has one addition to the rear of the house pre 1925. More recently, in 2021, a two story accessory structure was built at the rear of the property housing a 2 car garage with an accessory dwelling unit above.

The proposed work consists of removing portions of the existing addition and building on top of it and the existing foundation. Portions of the addition will extend a little over 12 inches further into the back yard than the existing footprint. The new addition will contain a kitchen and family room on the ground floor and a bedroom suite and office on the second floor.

The original 1898 home will not be altered except where the addition ties into the existing roof using a low slope membrane on the addition to limit that impact. Recent repairs to the original siding have been made with custom siding to match the unique profile of the existing.

New materials are depicted on the attached drawings and will essentially be consistent with the original home although using contemporary materials similar to the 2021 garage and ADU. For instance cementitious lap siding and trim will be used with similar exposure and paint color but not reproducing the historic home's profile. Clad wood casement windows will differentiate the addition from the historic double hung windows that prevail (many of which have been replaced over time with varying materials).

The proposed addition is visible from the alley when looking over adjacent property parking areas. The new work is minimally visible from Chimborazo Boulevard due to the proximity and scale of the adjacent homes.

The proposed revision encloses the porch that was previously designed as a recess within the rear elevation. The bottom right quadrant of the rear elevation now mirrors the bottom left, with matching fenestration and a door. Windows on the side elevations have also been reconfigured.

Respectfully,

Andy Scudder, AIA
Johannas Design Group

CHURCH HILL REAR ADDITION

411 CHIMBORAZO BOULEVARD - COMMISSION OF ARCHITECTURAL REVIEW PRESENTATION

SHEET INDEX


CAR #	DESCRIPTION	REVISION NO.	DATE
CAR 01	COVER SHEET	-	
CAR 02	SITE PLAN	1	02/02/26
CAR 03	EXISTING PLANS	-	
CAR 04	PROPOSED PLANS	1	02/02/26
CAR 05	PROPOSED ELEVATIONS	1	02/02/26
CAR 06	PHOTOS	-	



STREET VIEW


SURVEY

NTS

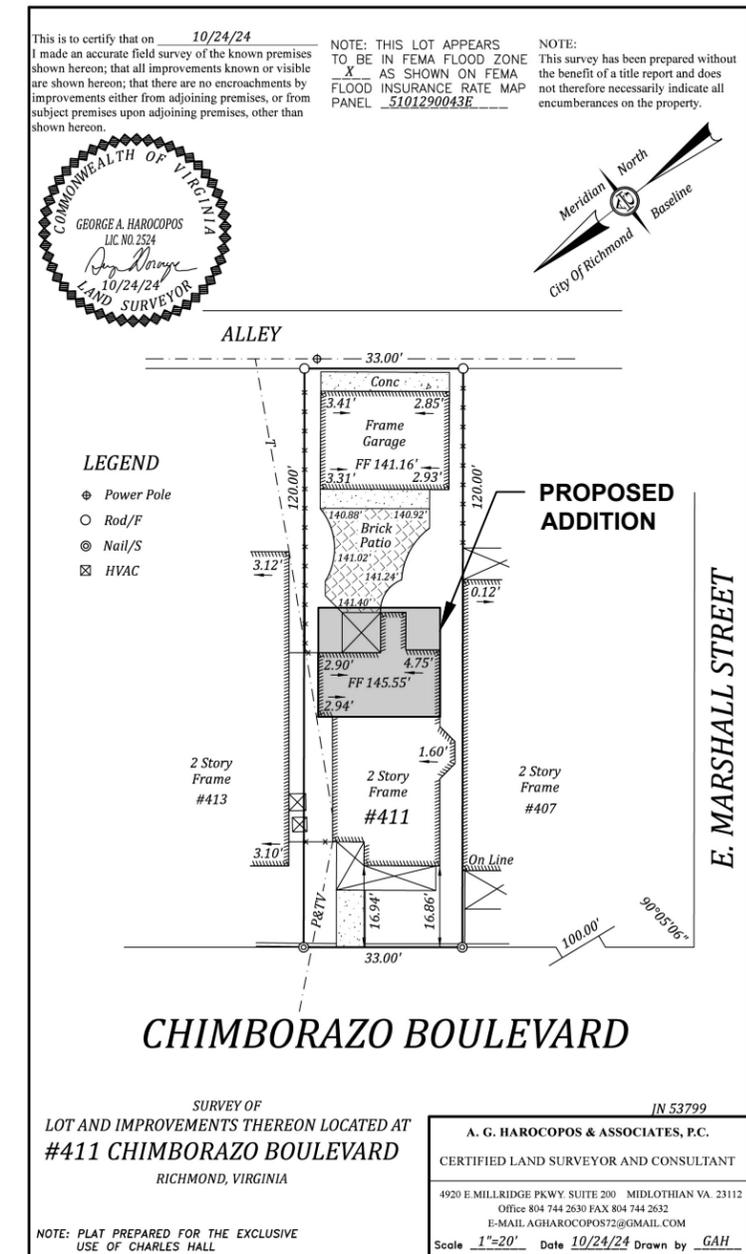

LOCATION MAP

NTS

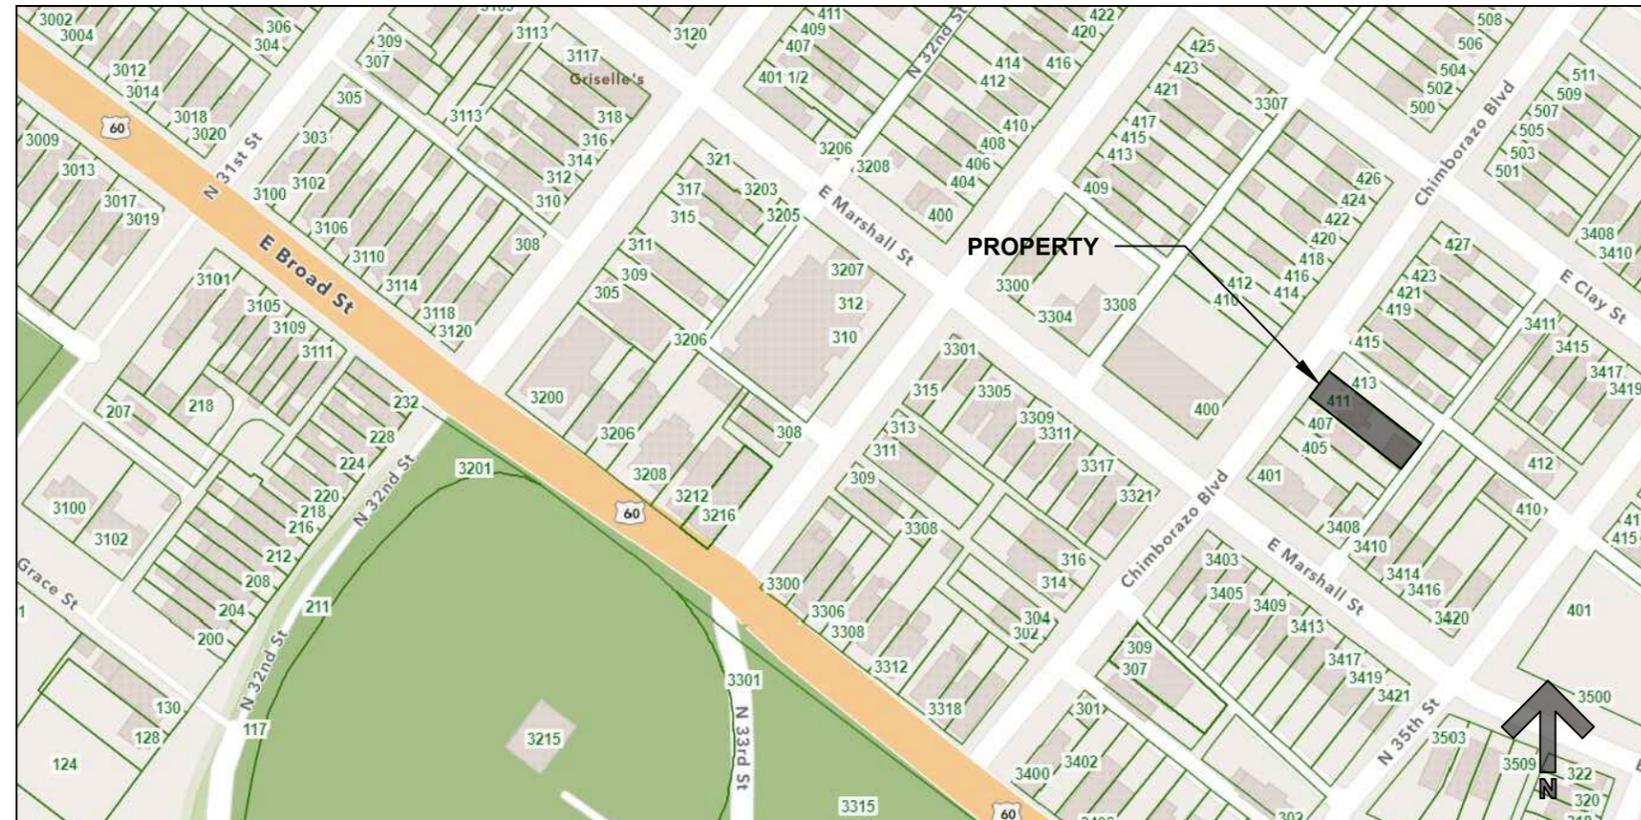

COPYRIGHT 2024 JOHANNAS DESIGN GROUP. © 2024 JOHANNAS DESIGN GROUP

REVISIONS

P 804.358.4993
 F 804.358.8211

VA 23220

RICHMOND, VA

1901 WEST CARY STREET

DESIGN GROUP

JOHANNAS

411 CHIMBORAZO BLVD

SHEET TITLE

COVER SHEET

SHEET TITLE

COVER SHEET

PROJECT NO.

2423

DATE

05/16/2025

SHEET NO.


CAR 01



VIEW 2 - LOOKING WEST




VIEW 1 - LOOKING SOUTHEAST

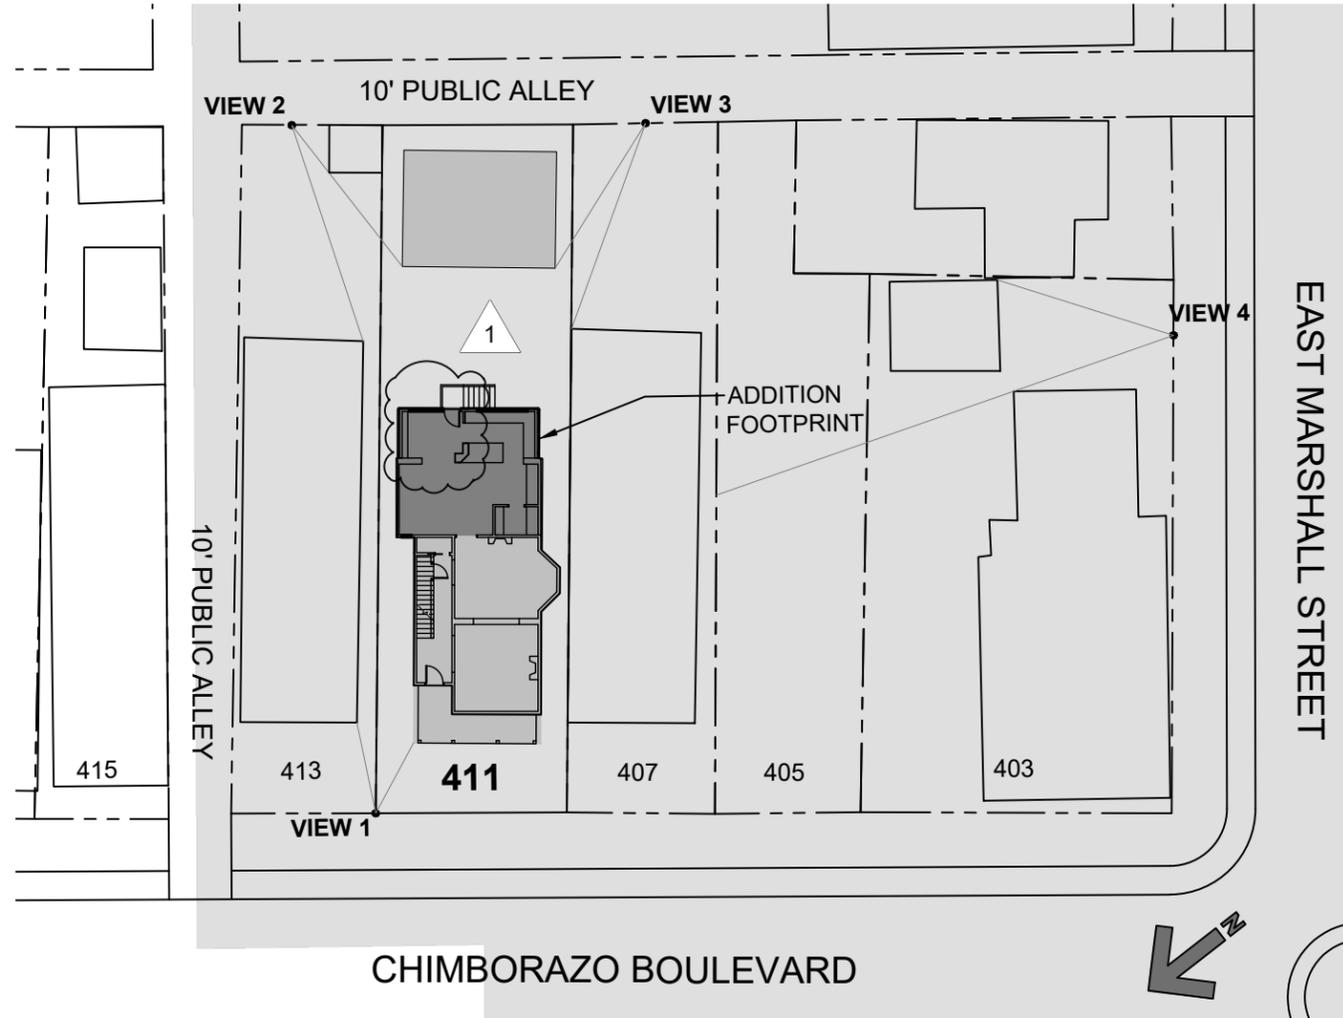

- EXISTING BUILDING
- ADDITION FOOTPRINT
- CAR DISTRICT

SITE PLAN

1/32" = 1'-0"

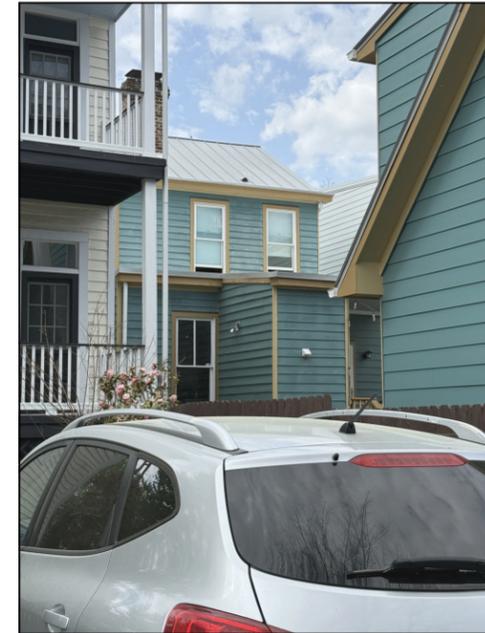

VIEW 3 - LOOKING NORTH



VIEW 4 - LOOKING NORTHEAST
(not visible)

REVISIONS
1 - 02/02/26

ENCLOSING
PORCH

P 804.358.4993 F 804.358.8211
1901 WEST CARY STREET RICHMOND, VA 23220

411 CHIMBORAZO BLVD

SHEET TITLE

SITE PLAN

PROJECT NO.


2423

DATE

05/16/2025


SHEET NO.

CAR 02

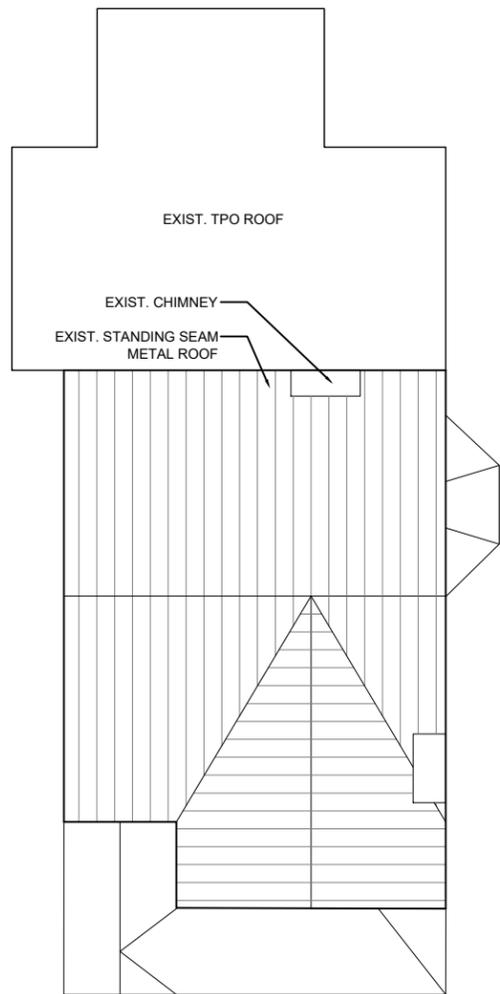


EXISTING ROOF PLAN

3/32" = 1'-0"

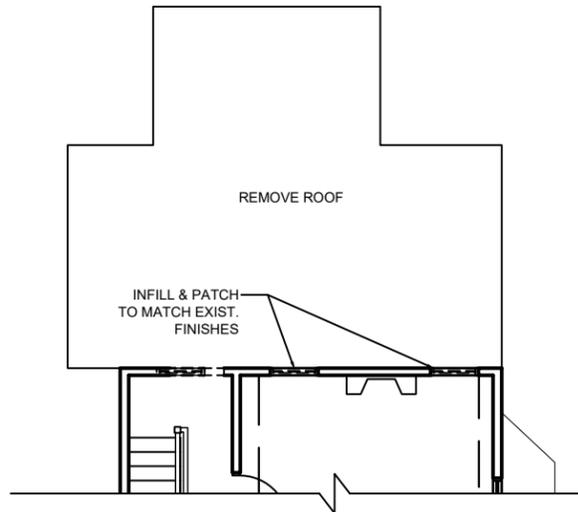


SECOND FLOOR DEMO PLAN

3/32" = 1'-0"

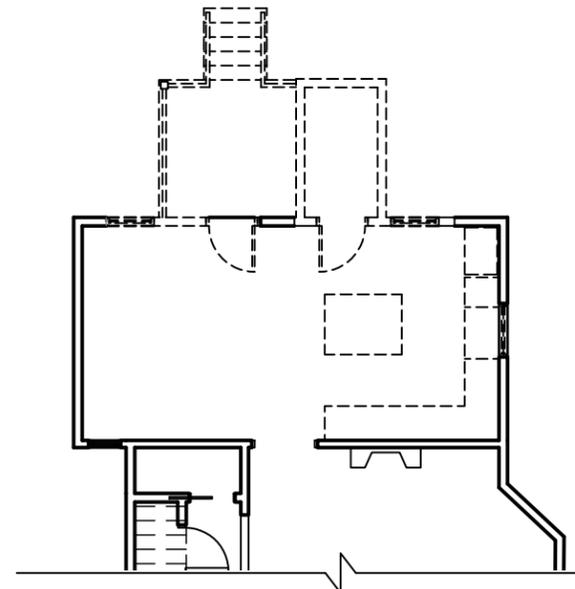


FIRST FLOOR DEMO PLAN

3/32" = 1'-0"

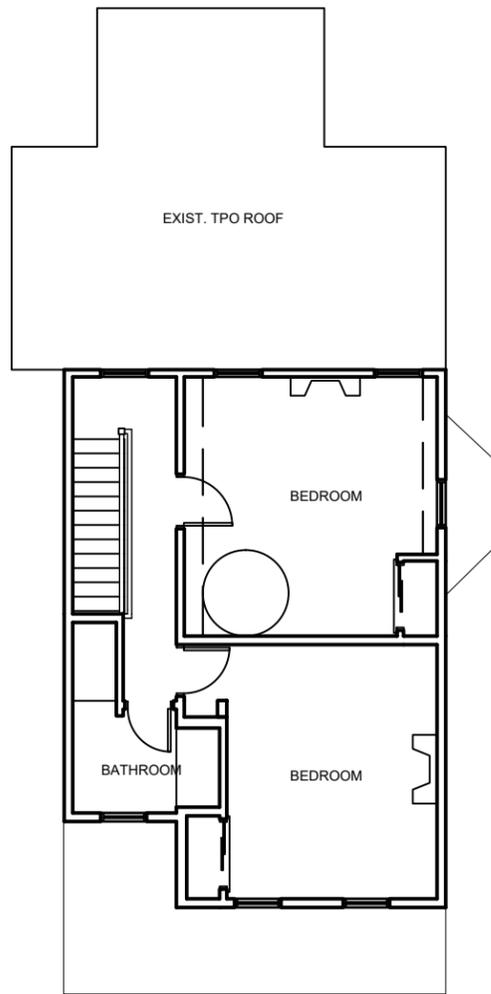



EXISTING SECOND FLOOR PLAN

3/32" = 1'-0"

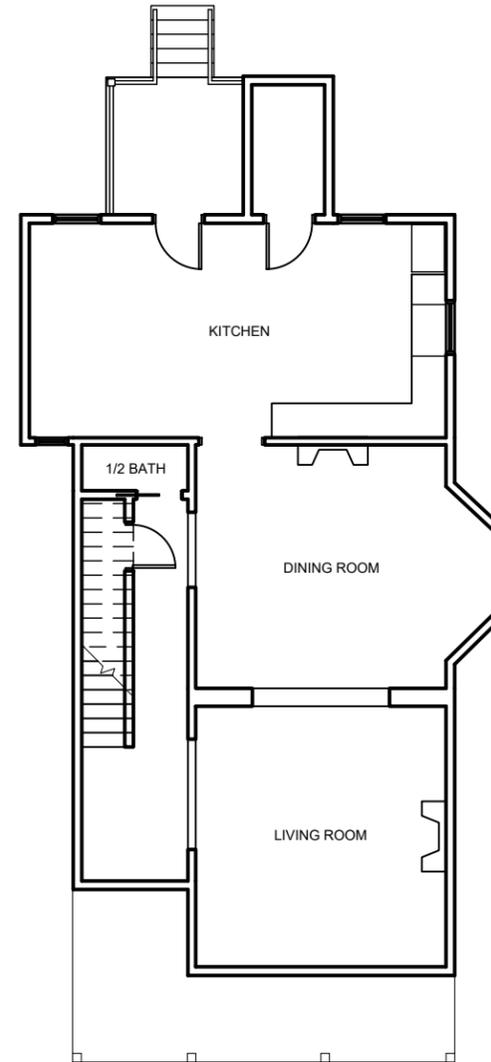



EXISTING FIRST FLOOR PLAN

3/32" = 1'-0"

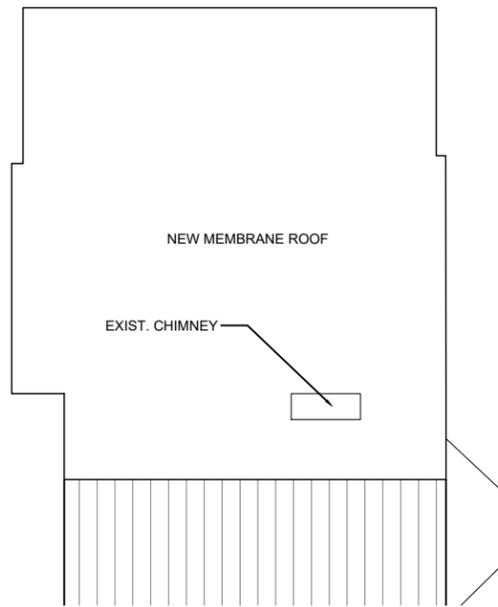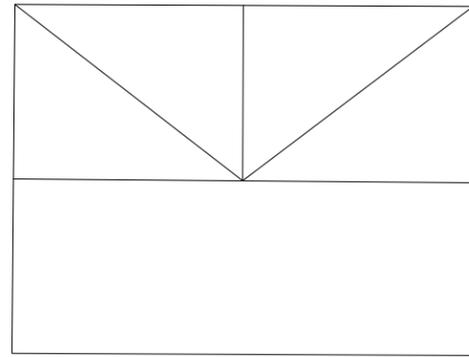


PROPOSED ROOF PLAN

3/32" = 1'-0"

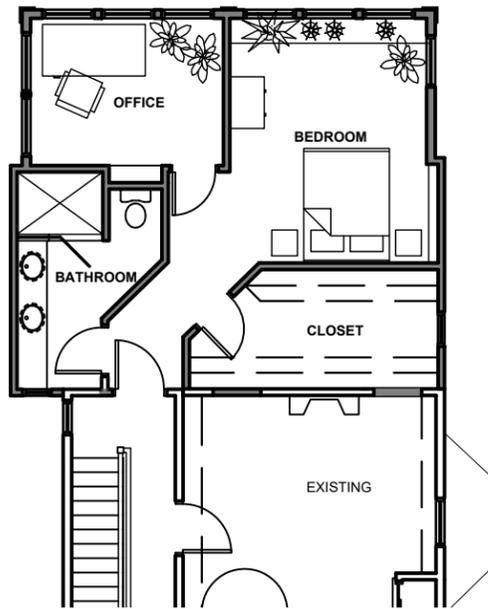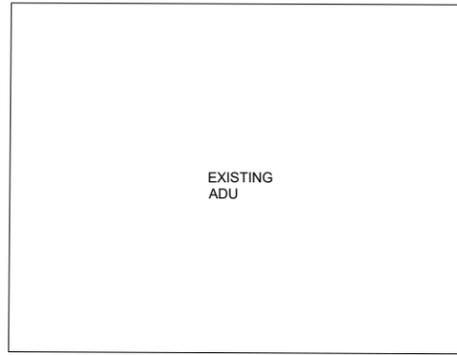

PROPOSED SECOND FLOOR PLAN

3/32" = 1'-0"

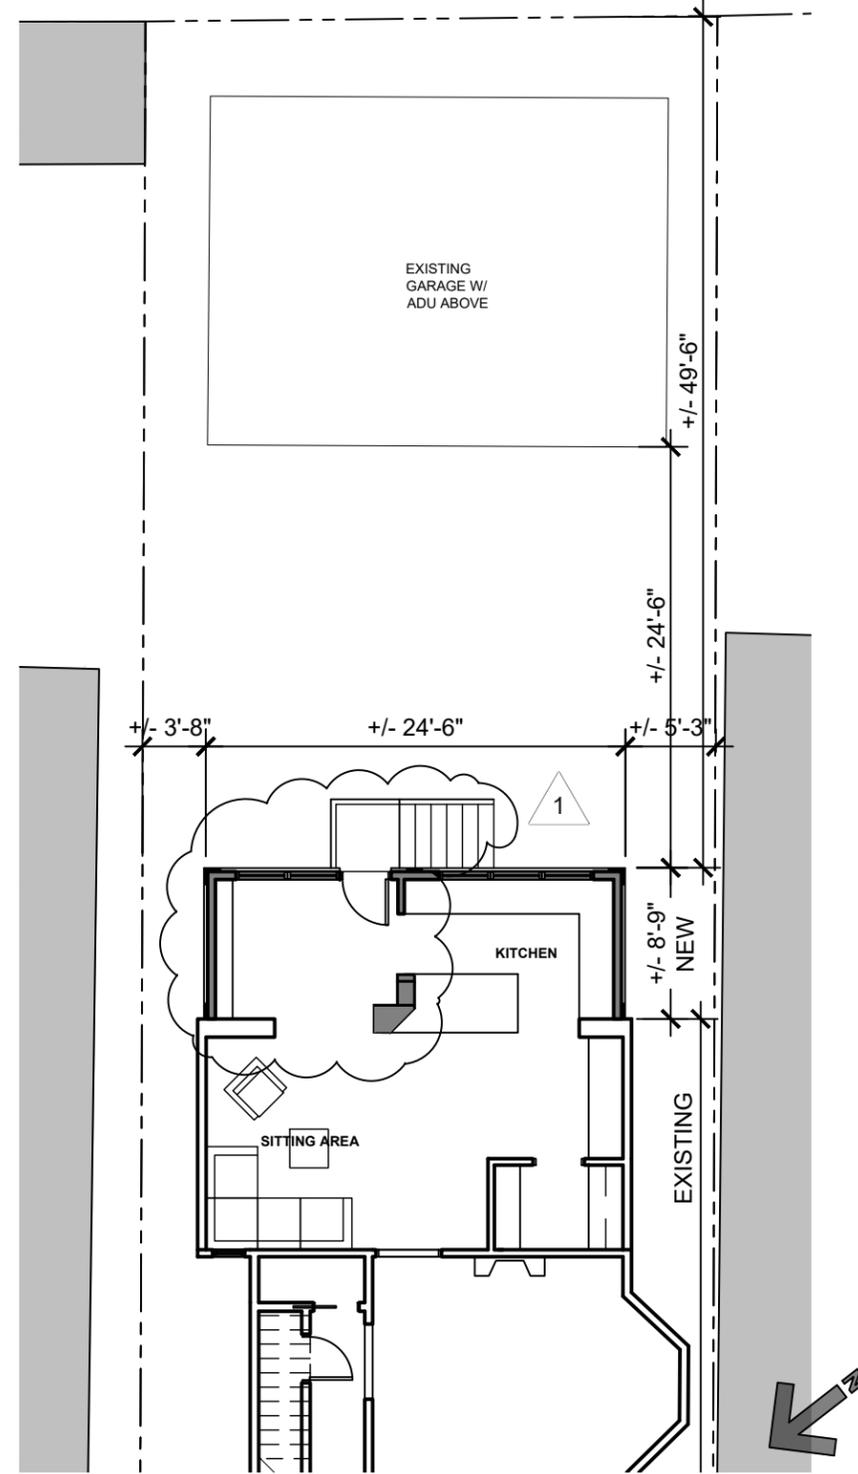

PROPOSED FIRST FLOOR PLAN

3/32" = 1'-0"

JOHANNAS DESIGN GROUP 1901 WEST CARY STREET RICHMOND, VA 23220 P 804.358.4993 F 804.358.8211

REVISIONS

1 - 02/02/26

ENCLOSING PORCH

411 CHIMBORAZO BLVD

SHEET TITLE

PLANS

PROJECT NO.


2423

DATE


05/16/2025

SHEET NO.


CAR 04

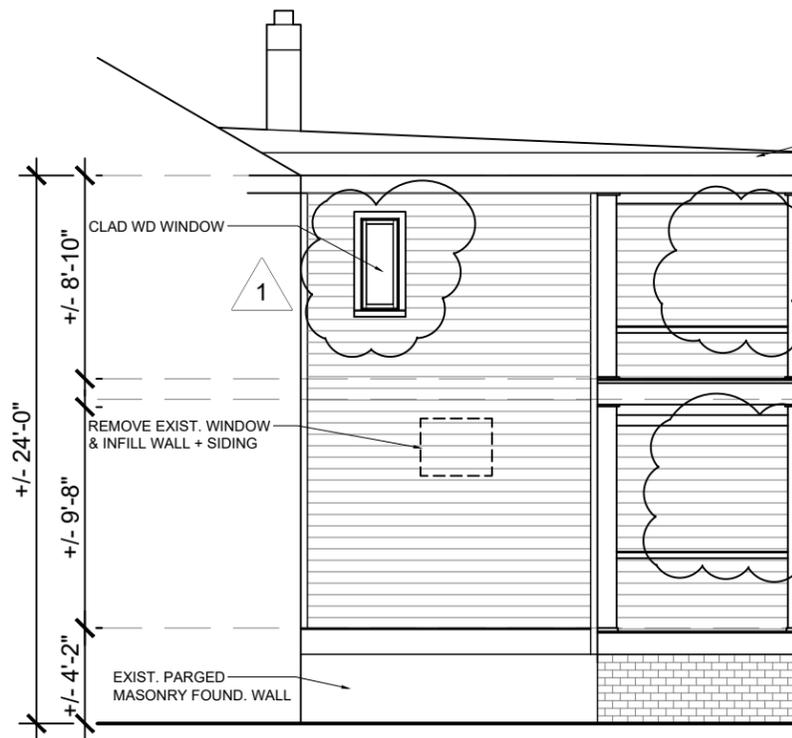


PROPOSED SW ELEVATION
1/8" = 1'-0"

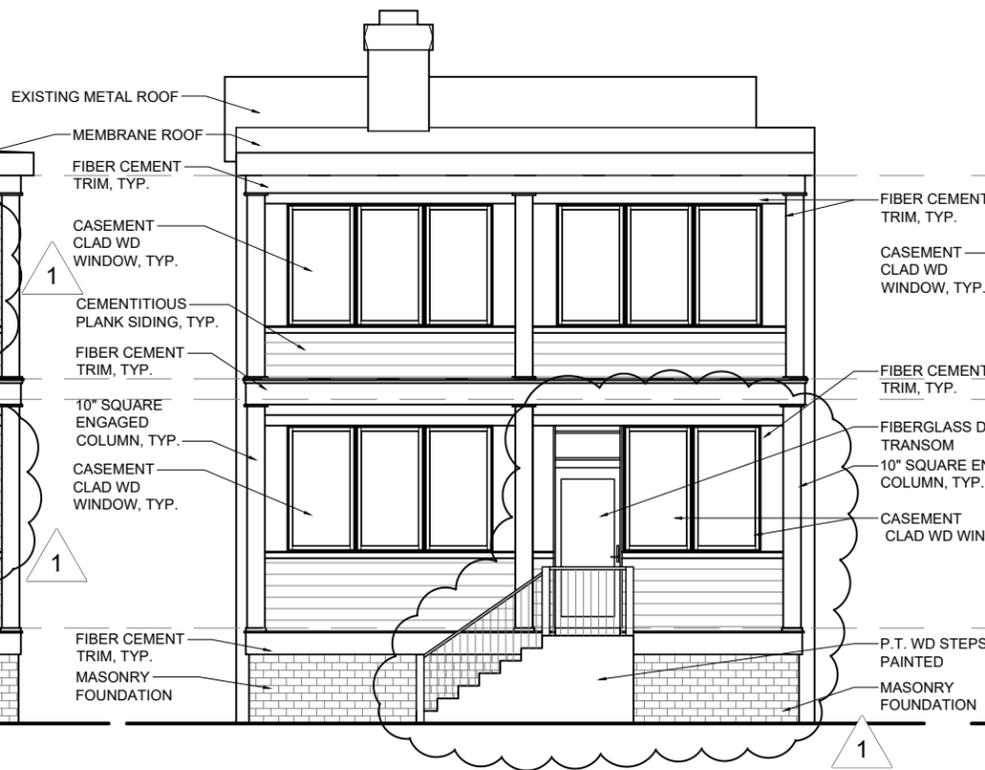

PROPOSED SE ELEVATION
1/8" = 1'-0"

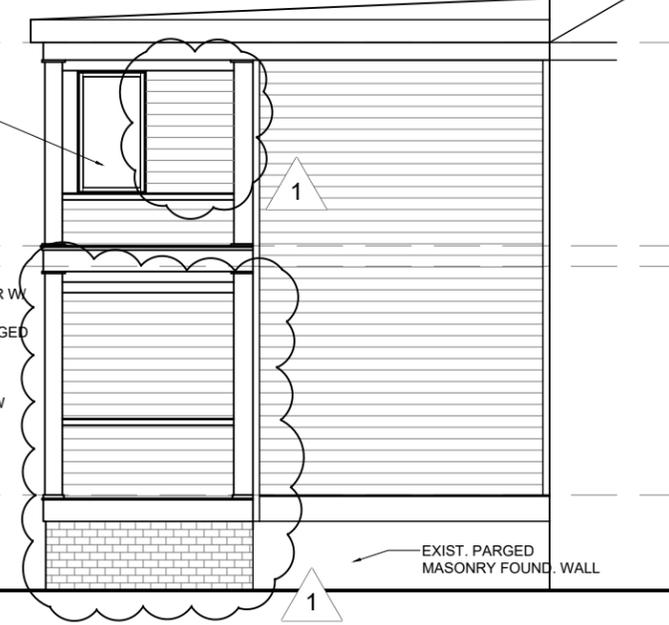


PROPOSED NE ELEVATION
1/8" = 1'-0"

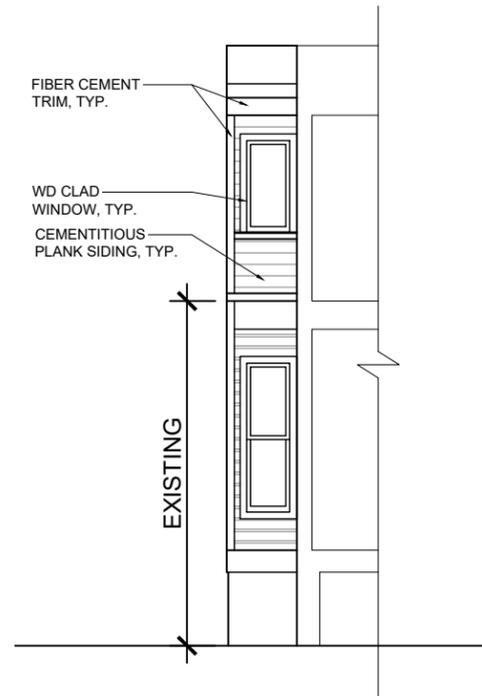

PROPOSED NW ELEVATION
1/8" = 1'-0"

J O H A N N A S DESIGN GROUP 1901 WEST CARY STREET RICHMOND, VA 23220 P 804.358.4993 F 804.358.8211

REVISIONS
1 - 02/02/26
ENCLOSING PORCH
411 CHIMBORAZO BLVD
SHEET TITLE
ELEVATIONS
PROJECT NO.
2423
DATE
05/16/2025
SHEET NO.
CAR 05

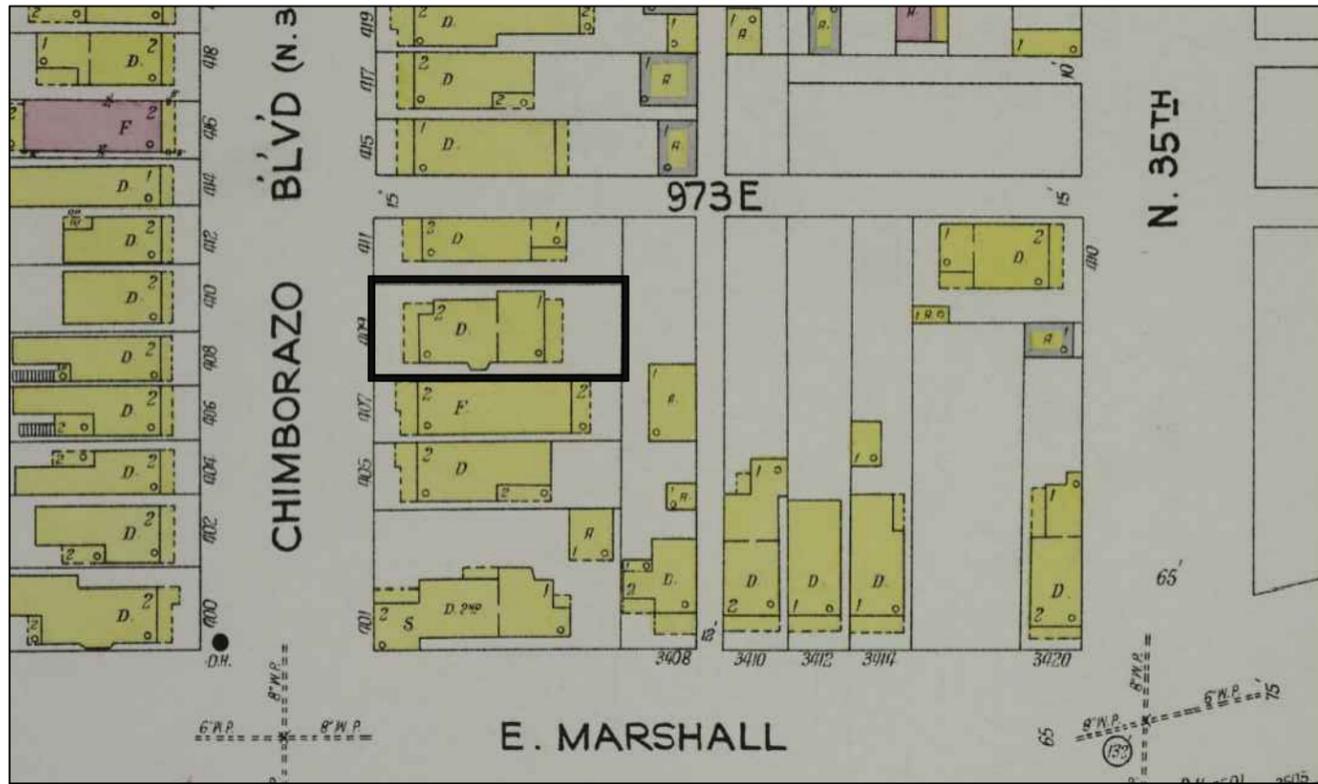

1925 SANBORN PANEL 238



SW ELEVATION



SE ELEVATION



NE ELEVATION



NW ELEVATION