


EAST ELEVATION

1/8" = 1'-0"

615 Maple Avenue  
 Garage Exhibit, Relative Heights of As-Built to By Right Garage Designs, 10/6/2023

Dimensions & Linework:

- As built shown in **Red**, 10:12 Roof Pitch
- Alternate 1, below 12' requirement in **Blue**, 2:12 Roof Pitch (Low Slope)
- Alternate 2, at 6' setback with 20' maximum build in **Green**, 10.25:12 Roof Pitch
- Alternate 3, at 6' setback with 20' maximum build and low slope roof in **Purple**, 2:12 Roof Pitch

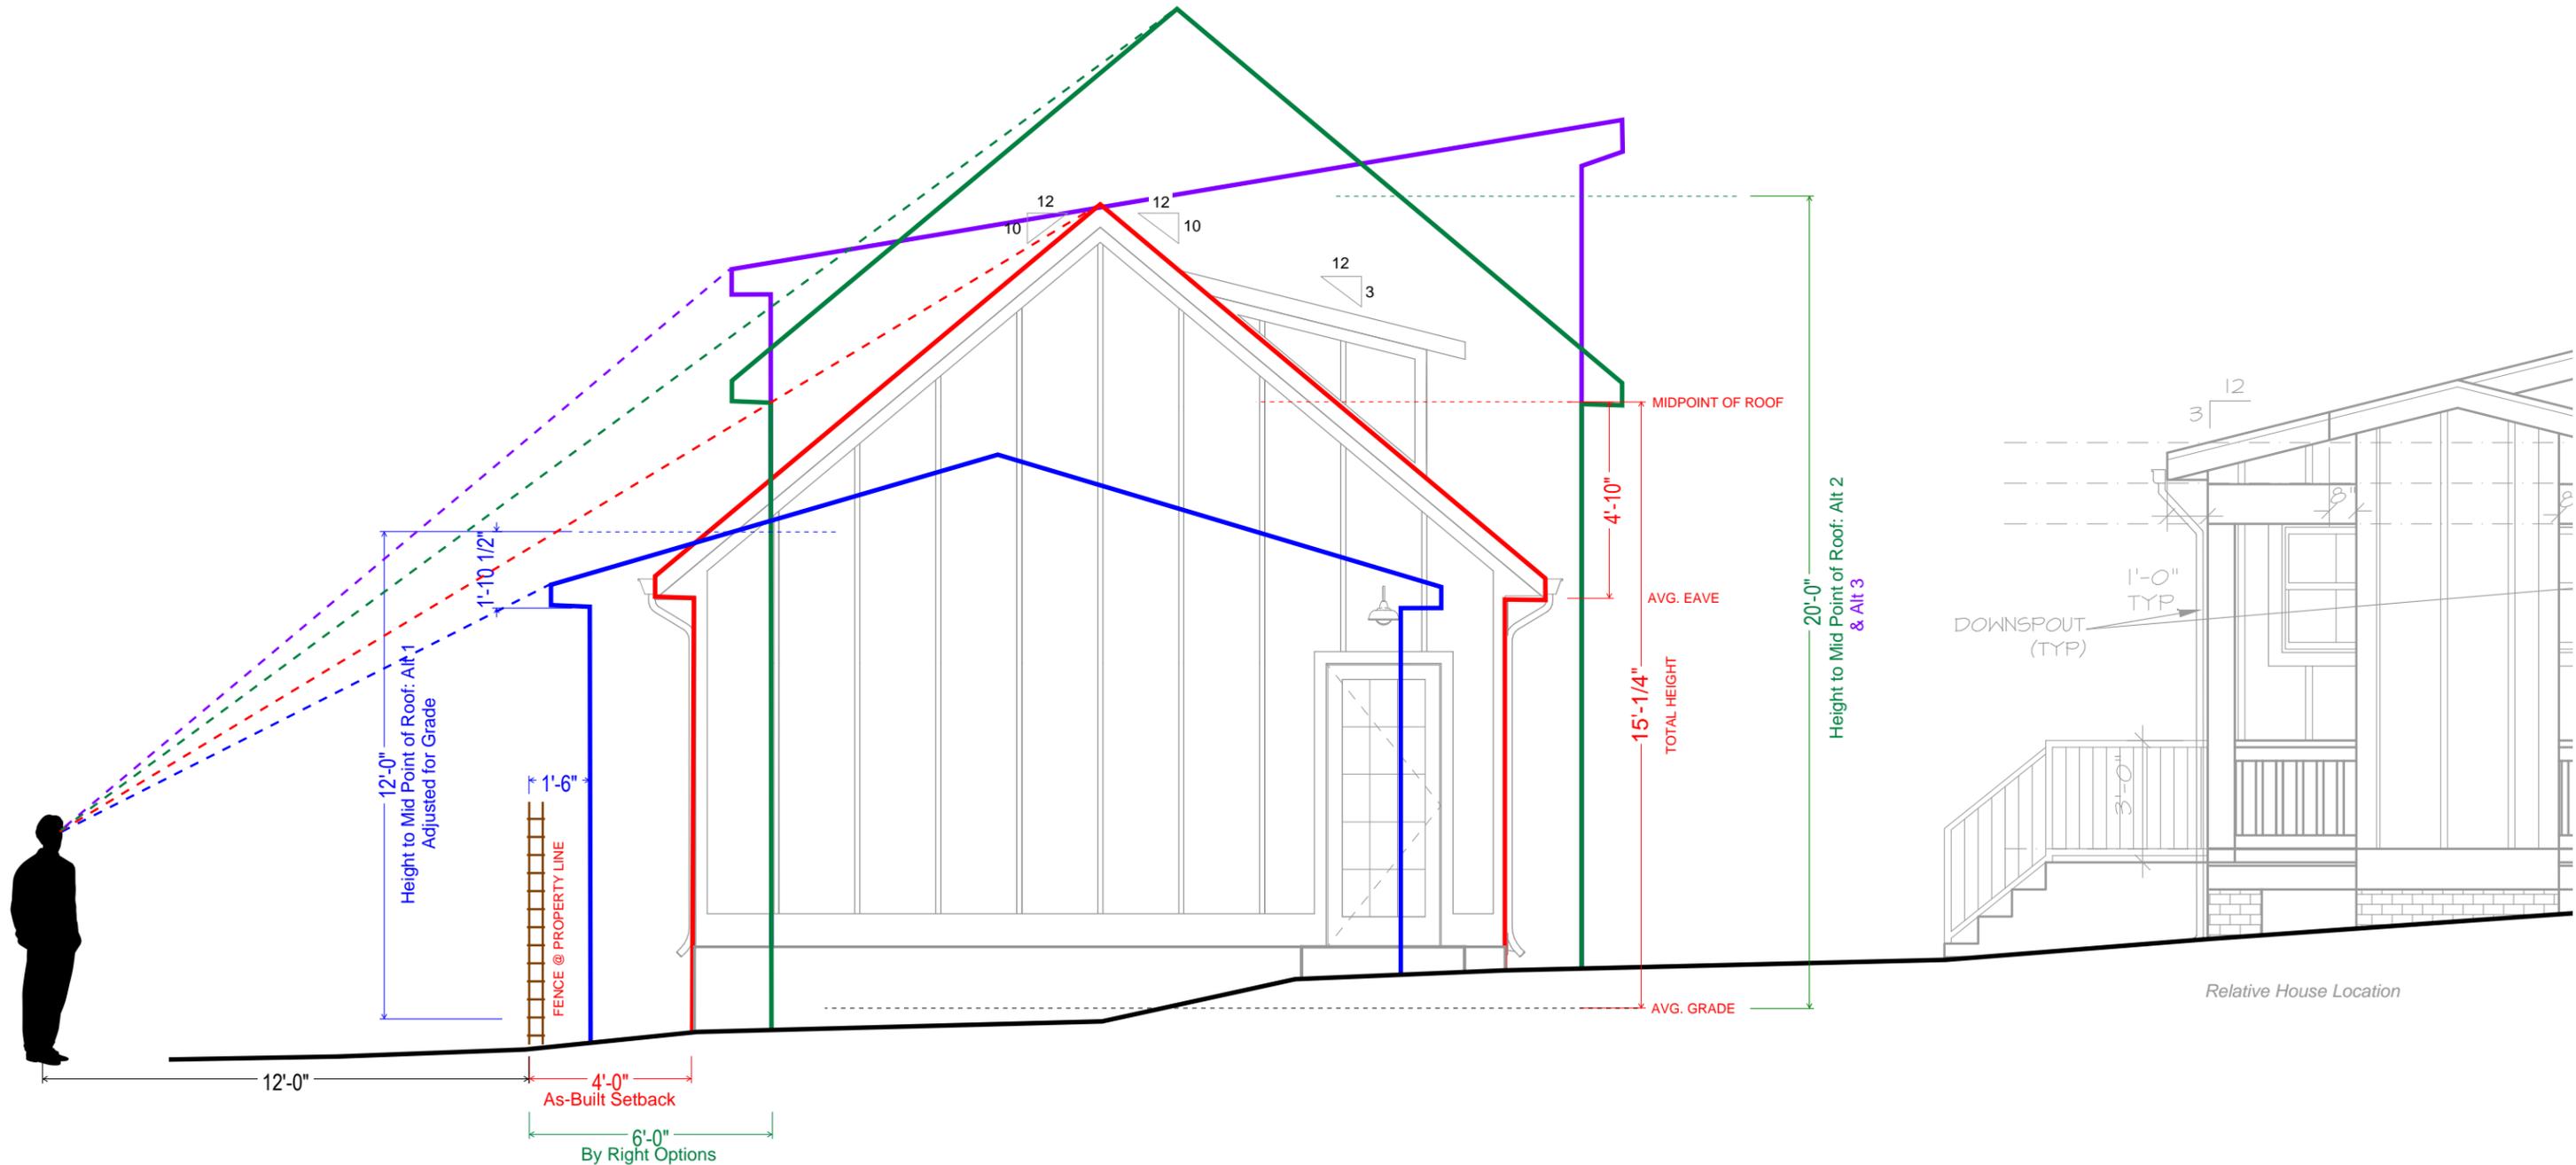

**EAST ELEVATION**  
 1/4" = 1'-0"