

Reviewed per the 2015 Virginia Residential Code. The code can be read at the link below.  
<https://codes.iccsafe.org/content/VRC2015>


**Building Permit - Approved Construction Documents**  
Under general authority of the Building Code, this approved set of construction documents shall be kept on the job site at all times and shall not be altered without approval from the Building Official. This permit does not approve any Electrical, Mechanical or Plumbing work. This approval does not relieve the builder from complying with manufacturer instructions, Virginia Uniform Statewide Building Code and City of Richmond regulations whether noted, implied or omitted.  
Plans-20210407-1012-W-49th-St-BLDR-087614-2021 04/26/2021 1:37:21 AM

**BOUNDARLESS LIVING, LLC**  
5101 CALDEDONIA ROAD  
RICHMOND, VA 23225

Copyright ©HN, Inc.  
All reproduction and intellectual property rights reserved

1012 W49TH STREET  
1012 W49TH STREET  
RICHMOND, VA 23225

All reproduction + Intellectual property rights reserved

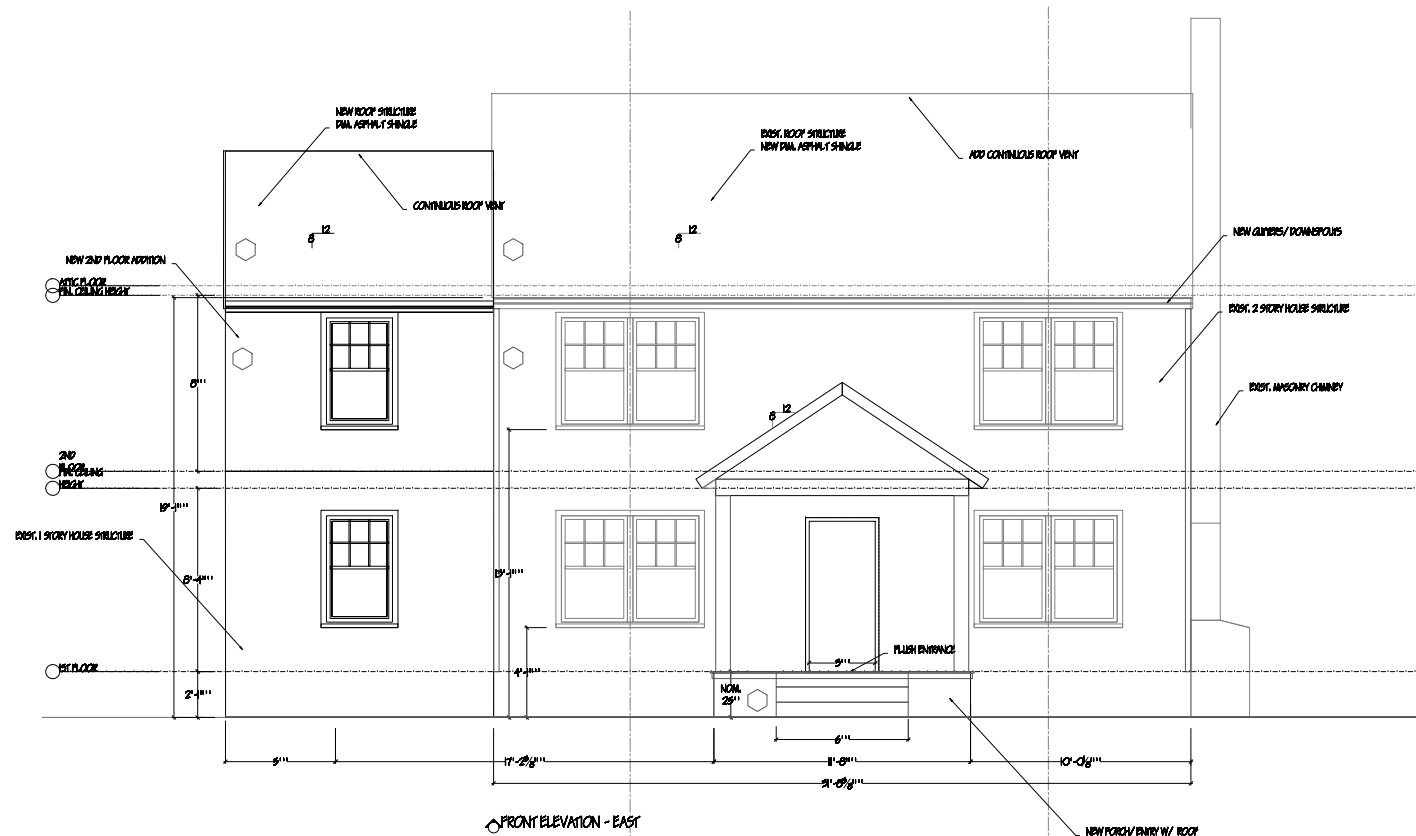

Drawn By: DHR  
Scale: 1/2"=1'  
Date: 1/15/21  
Revised date: 30/21

**FINAL - DHR,**  
9/29/21

PAGE 1

Field verify all dimensions and conditions, and obtain licensed engineer approval, prior to starting work and/or ordering materials

Reviewed per the 2015 Virginia Residential Code. The code can be read at the link below.  
<https://codes.iccsafe.org/content/VRC2015>


**Building Permit - Approved Construction Documents**  
Under general authority of the Building Code, this approved set of construction documents shall be kept on the job site at all times and shall not be altered without approval from the Building Official. This permit does not approve any Electrical, Mechanical or Plumbing work. This approval does not relieve the builder from complying with manufacturer's instructions, Virginia Uniform Statewide Building Code and City of Richmond regulations whether noted, implied or omitted.  
Plans-20210407-1012-W-49th-St-BLDR-087614-2021 04/26/2021 1:37:32 AM

**BOUNDARYLESS LIVING, LLC**  
5101 CALDEDONIA ROAD  
RICHMOND, VA 23225

Copyright ©HN, Inc.  
All reproduction and intellectual property rights reserved

1012 W49TH STREET  
1012 W49TH STREET  
RICHMOND, VA 23225

All reproduction + Intellectual property rights reserved

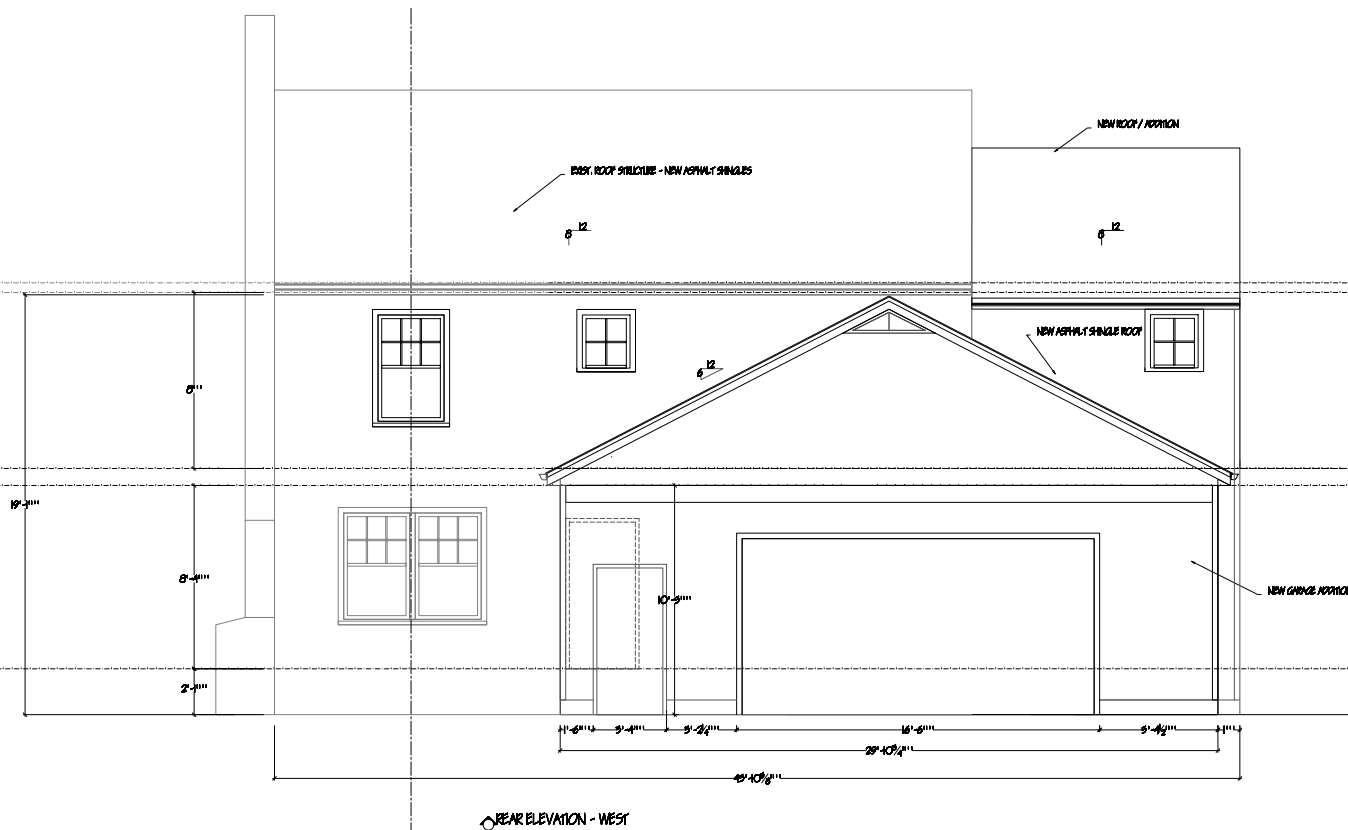

Drawn By: DHR  
Scale: 1/2"=1'  
Date: 1/15/21  
Revised date: 30/21, 4/2/21

**FINAL - DHR,**  
9/29/21

PAGE 2

Field verify all dimensions and conditions, and obtain licensed engineer approval, prior to starting work and/or ordering materials

Reviewed per the 2015 Virginia Residential Code. The code can be read at the link below.  
<https://codes.iccsafe.org/content/VRC2015>


**Building Permit - Approved Construction Documents**  
Under general authority of the Building Code, the approved set of construction documents shall be kept on the job site at all times and shall not be altered without approval from the Building Official. This permit does not approve any Electrical, Mechanical or Plumbing work. This approval does not relieve the builder from complying with manufacturer instructions, Virginia Uniform Building Code and City of Richmond regulations whether noted, implied or omitted.  
Plans: 20210407-1012-W-49th-St-BLDR-087614-2021 04/26/2021 7:37:38 AM J.E.

**BOUNDARLESS LIVING, LLC**  
5101 CALDEDONIA ROAD  
RICHMOND, VA 23225

Copyright ©HN, Inc.  
All reproduction and intellectual property rights reserved

1012 WA9TH STREET  
1012 WA9TH STREET  
RICHMOND, VA 23225

All reproduction + Intellectual property rights reserved

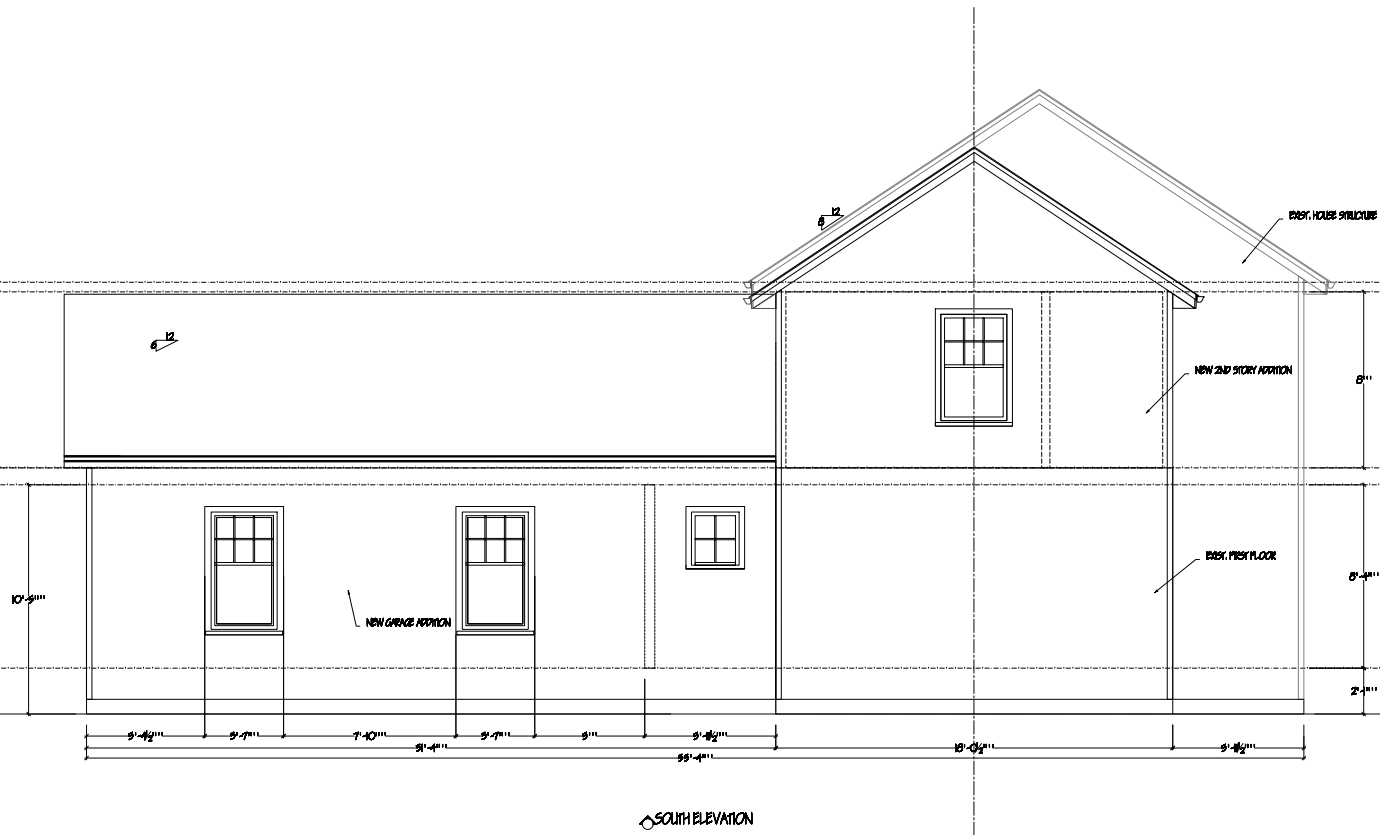


Drawn By: DHR  
Scale: 1/2"=1'  
Date: 1/15/21  
Revised date: 30/21

**FINAL - DHR,**  
**9/29/21**

PAGE 3

Field verify all dimensions and conditions, and obtain licensed engineer approval, prior to starting work and/or ordering materials

Field verify all dimensions and conditions, and obtain licensed engineer approval, prior to starting work and/or ordering materials

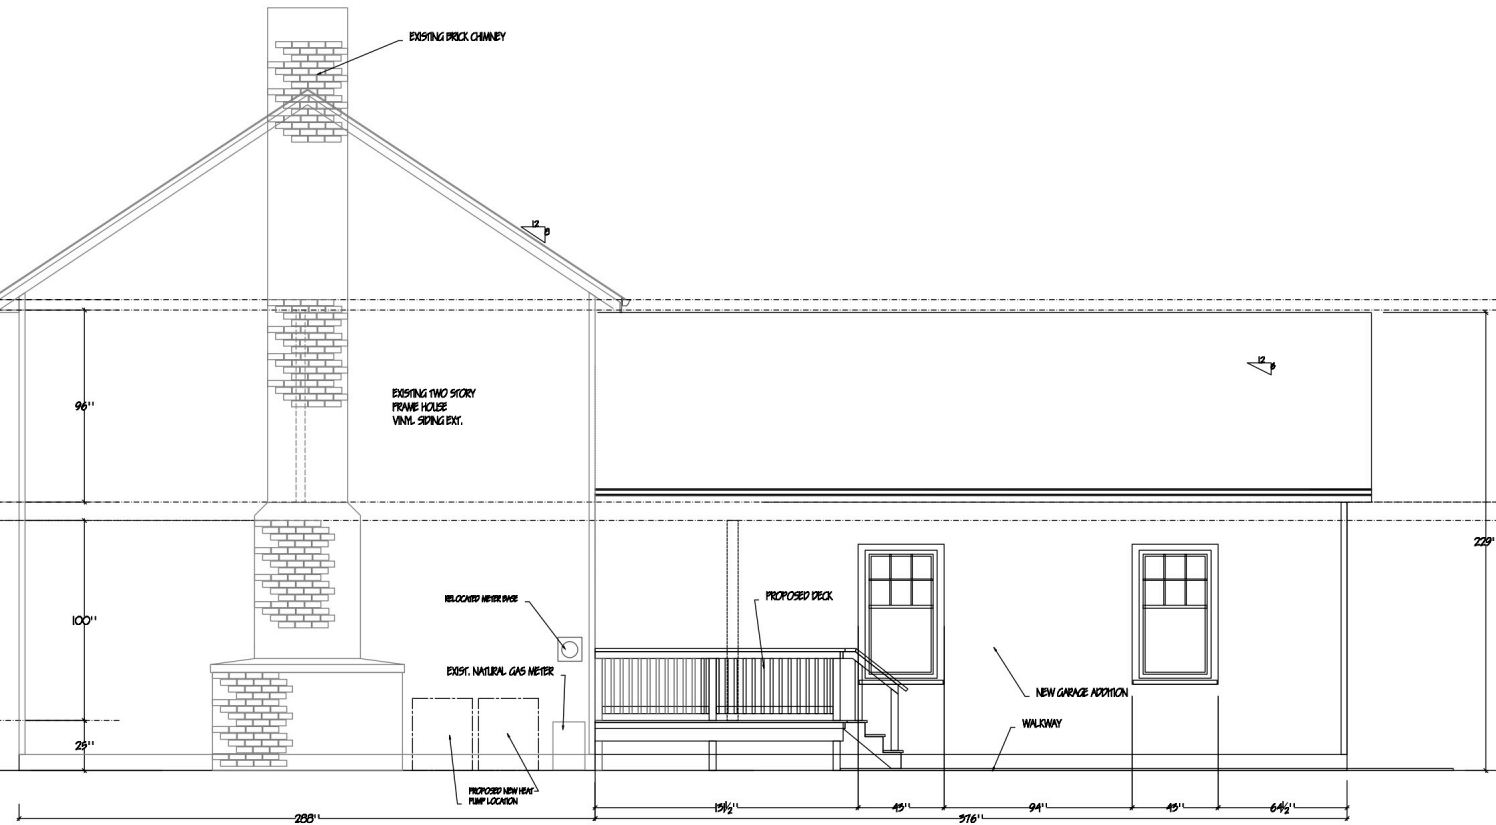

**NORTH ELEVATION**



**Building Permit - Approved Construction Documents**  
Under general authority of the Building Code, this approved set of construction documents shall be kept on the job site at all times and shall not be altered without approval from the Building Official. This permit does not approve any Electrical, Mechanical or Plumbing work. This approval does not relieve the builder from complying with all manufacturer's instructions, Virginia Uniform Statewide Building Code and City of Richmond regulations whether noted, implied or omitted.


Plans-20210407-1012-W-49th-St-BLDR-087614-2021 04/26/2021 7:37:46 AM

Copyright ©HN,INC.  
All reproduction and intellectual  
property rights reserved

All reproduction + intellectual property rights reserved

1/15/21, 1/26/21, 1/29/21  
1/30/21  
2/20/21  
2/23/21, 4/2/21  
PAGE 4 FOUNDATION


Field verify all dimensions and conditions, and obtain licensed engineer approval, prior to starting work and/or ordering materials

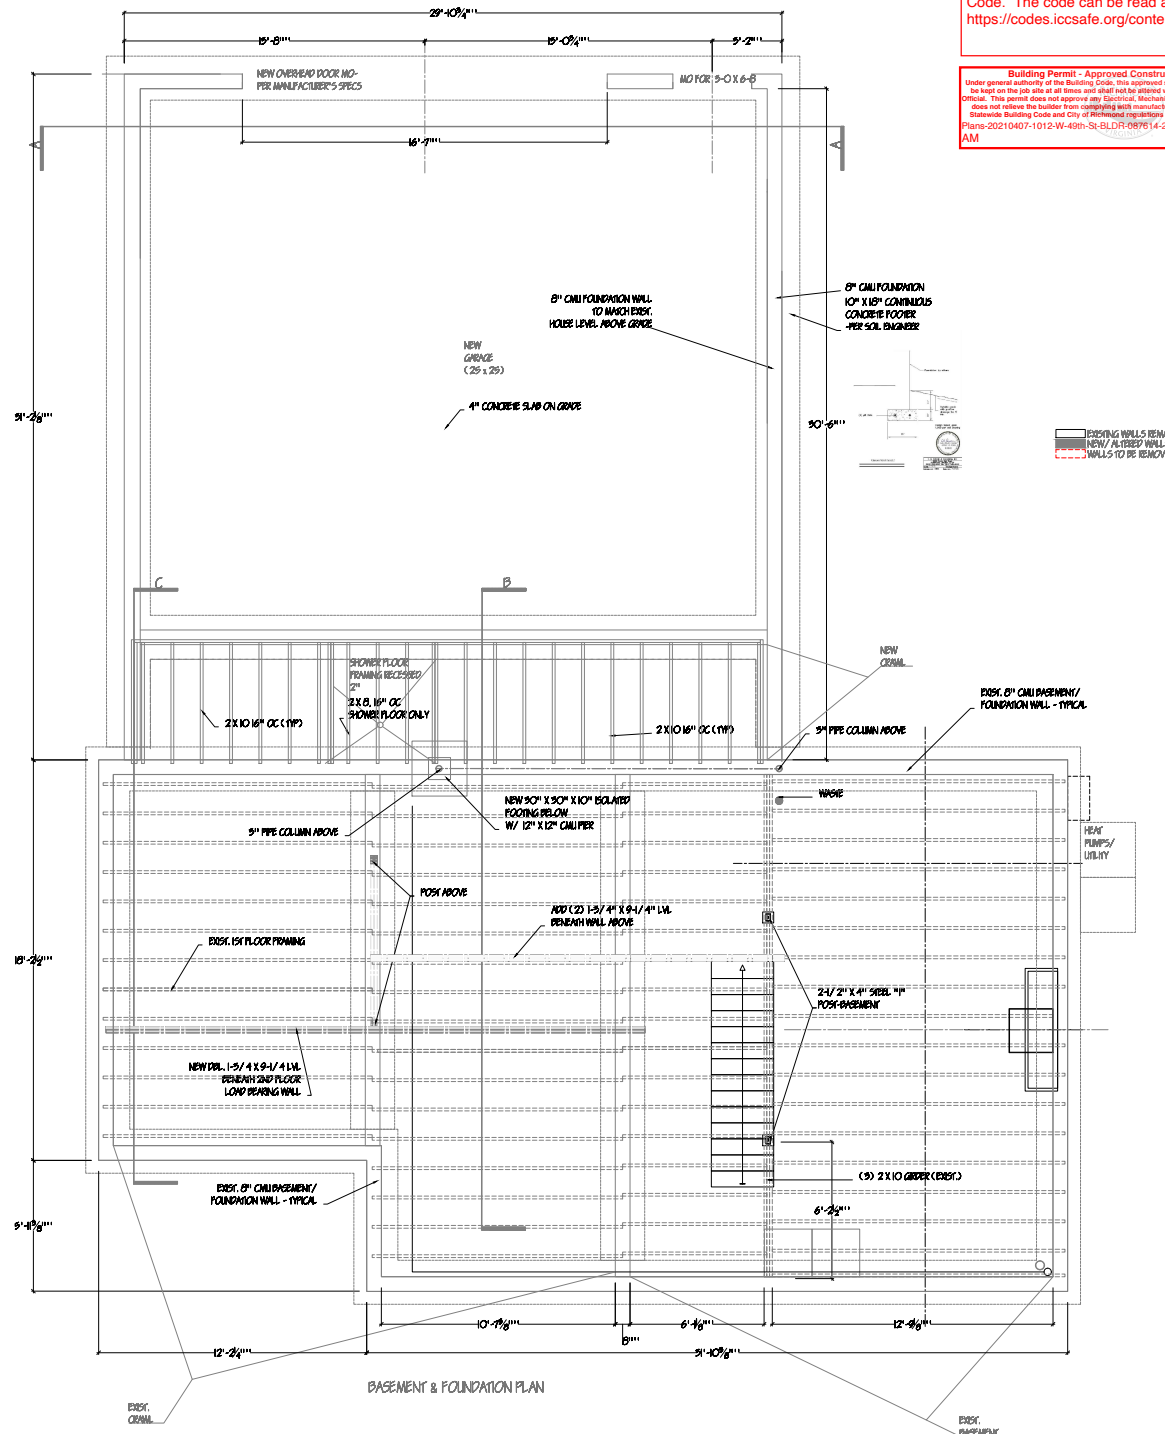

All reproduction + intellectual property rights reserved

FINAL DI

Field verify all dimensions and conditions, and obtain licensed engineer approval, prior to starting work and/or ordering materials

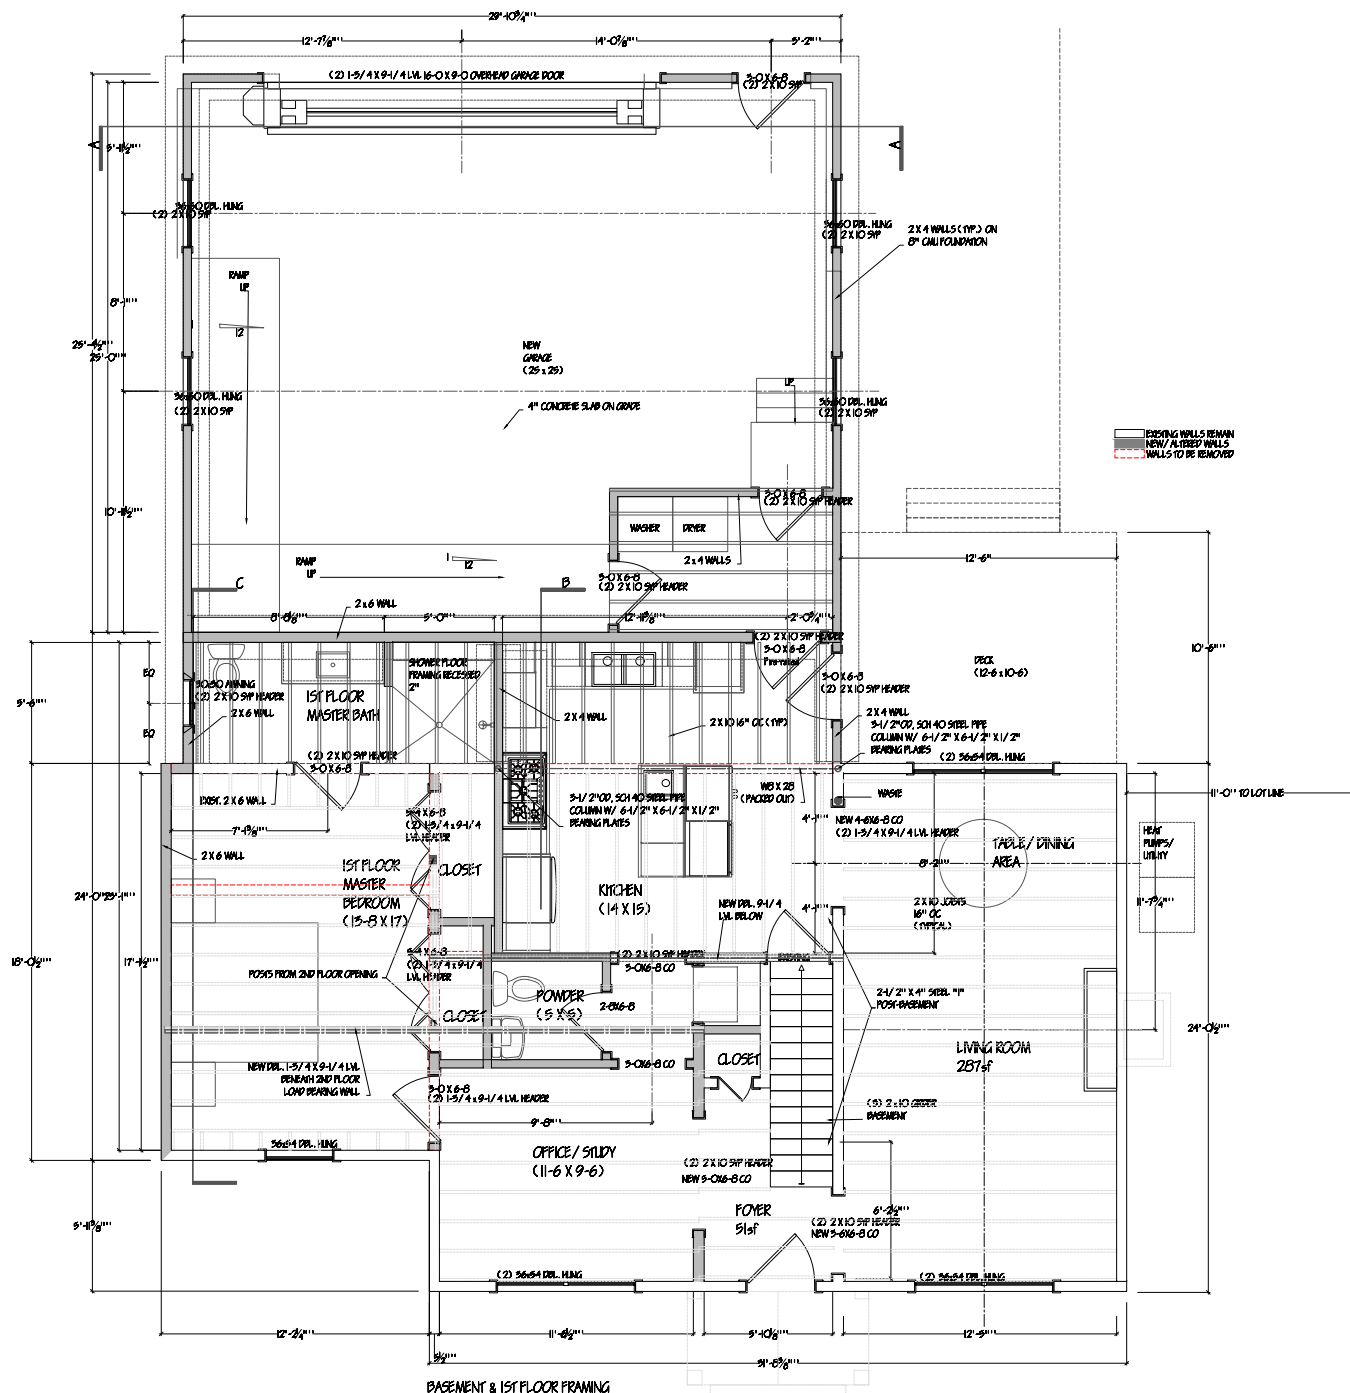


**BASEMENT & 1ST FLOOR FRAMING**

**Building Permit - Approved Construction Documents**  
Under general authority of the Building Code, this approved set of construction documents shall be kept on the job site at all times and shall not be altered without approval from the Building Official. This permit does not approve any Electrical, Mechanical or Plumbing work. This approval does not relieve the builder from complying with manufacturer instructions, Virginia Uniform Statewide Building Code and City of Richmond regulations whether noted, implied or omitted.  
Plans-20210407-1012-W-49th-St-BLDR-087614-2021 04/26/2021 7:36:58 AM

Reviewed per the 2015 Virginia Residential Code. The code can be read at the link below.  
<https://codes.iccsafe.org/content/VRC2015>

1012 WA9TH STREET  
1012 WA9TH STREET  
RICHMOND, VA 23225

All reproduction + Intellectual property rights reserved

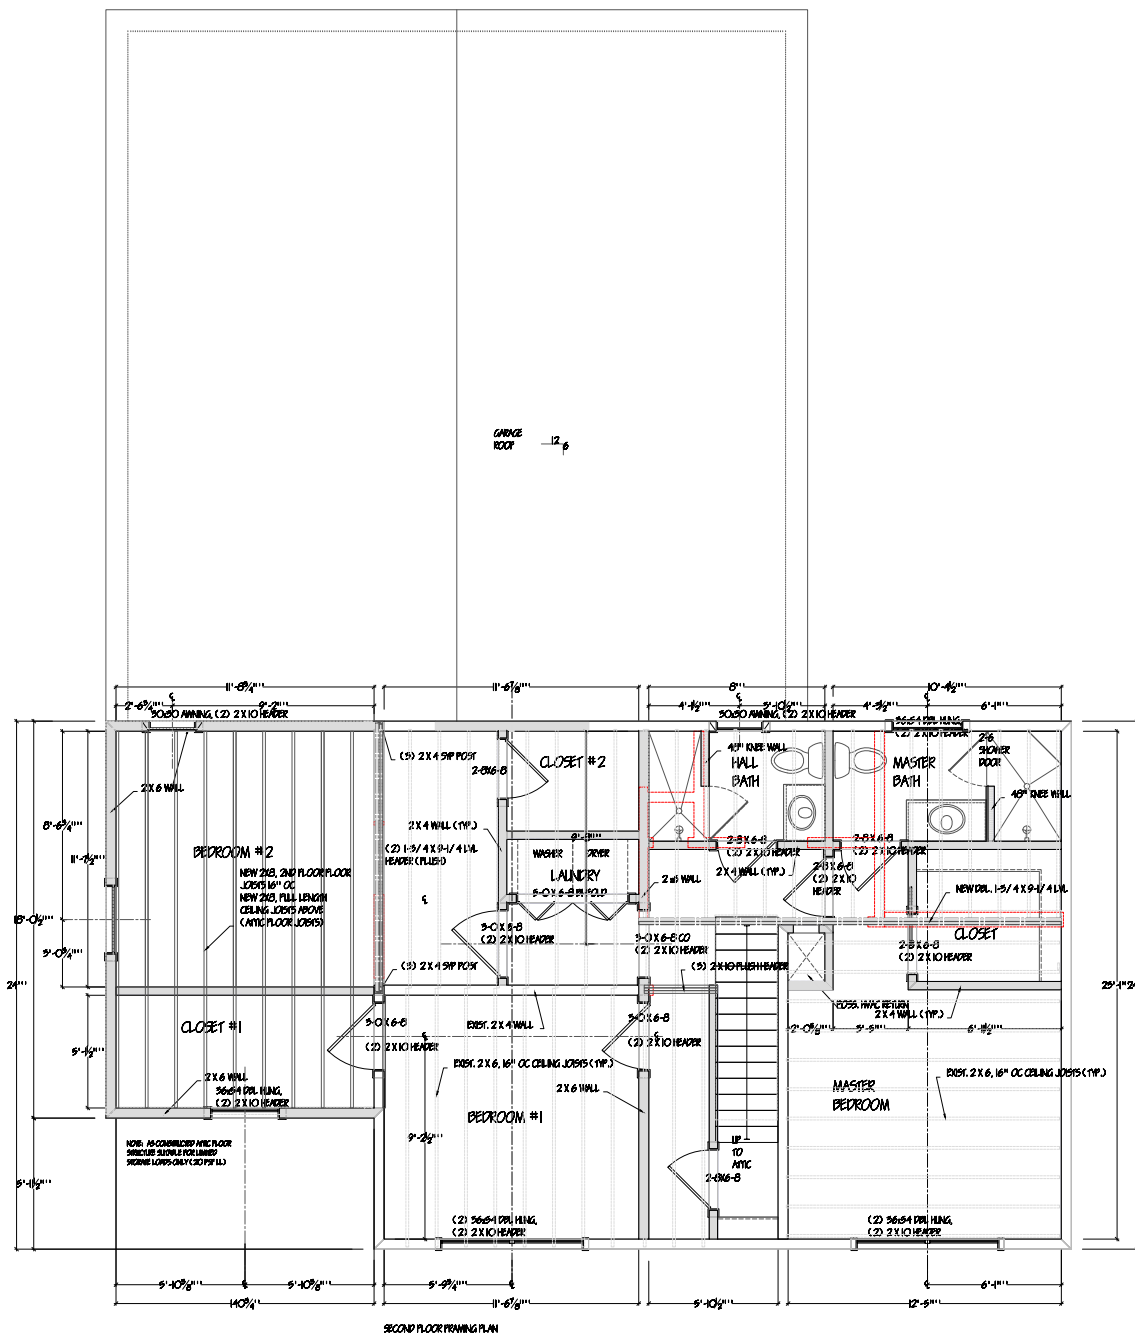


Reviewed per the 2015 Virginia Residential Code. The code can be read at the link below.  
<https://codes.iccsafe.org/content/VRC2015>

Building Permit - Approved Construction Documents  
Under general authority of the Building Code, this approved set of construction documents shall be kept on the job site at all times and shall not be altered without approval from the Building Official. This permit does not approve any Electrical, Mechanical or Plumbing work. This approval does not relieve the builder from complying with manufacturer's instructions, Virginia Uniform Statewide Building Code and City of Richmond regulations whether noted, implied or omitted.  
Plans: 20210407-1012-W-4900-St-BL-DR-08/14-2021 04/26/2021 7:37:55 AM

Drawn By: DHR  
Scale: 1/4"=1'  
Date: 11/23/20  
Revised date: 7/20, 12/8/20, 1/5/21  
1/15/21, 1/26/21  
1/30/21  
2/20/21  
2/23/21, 4/2/21  
PAGE 6

FINAL - DHR, 9/29/21

Field verify all dimensions and conditions, and obtain licensed engineer approval, prior to starting work and/or ordering materials

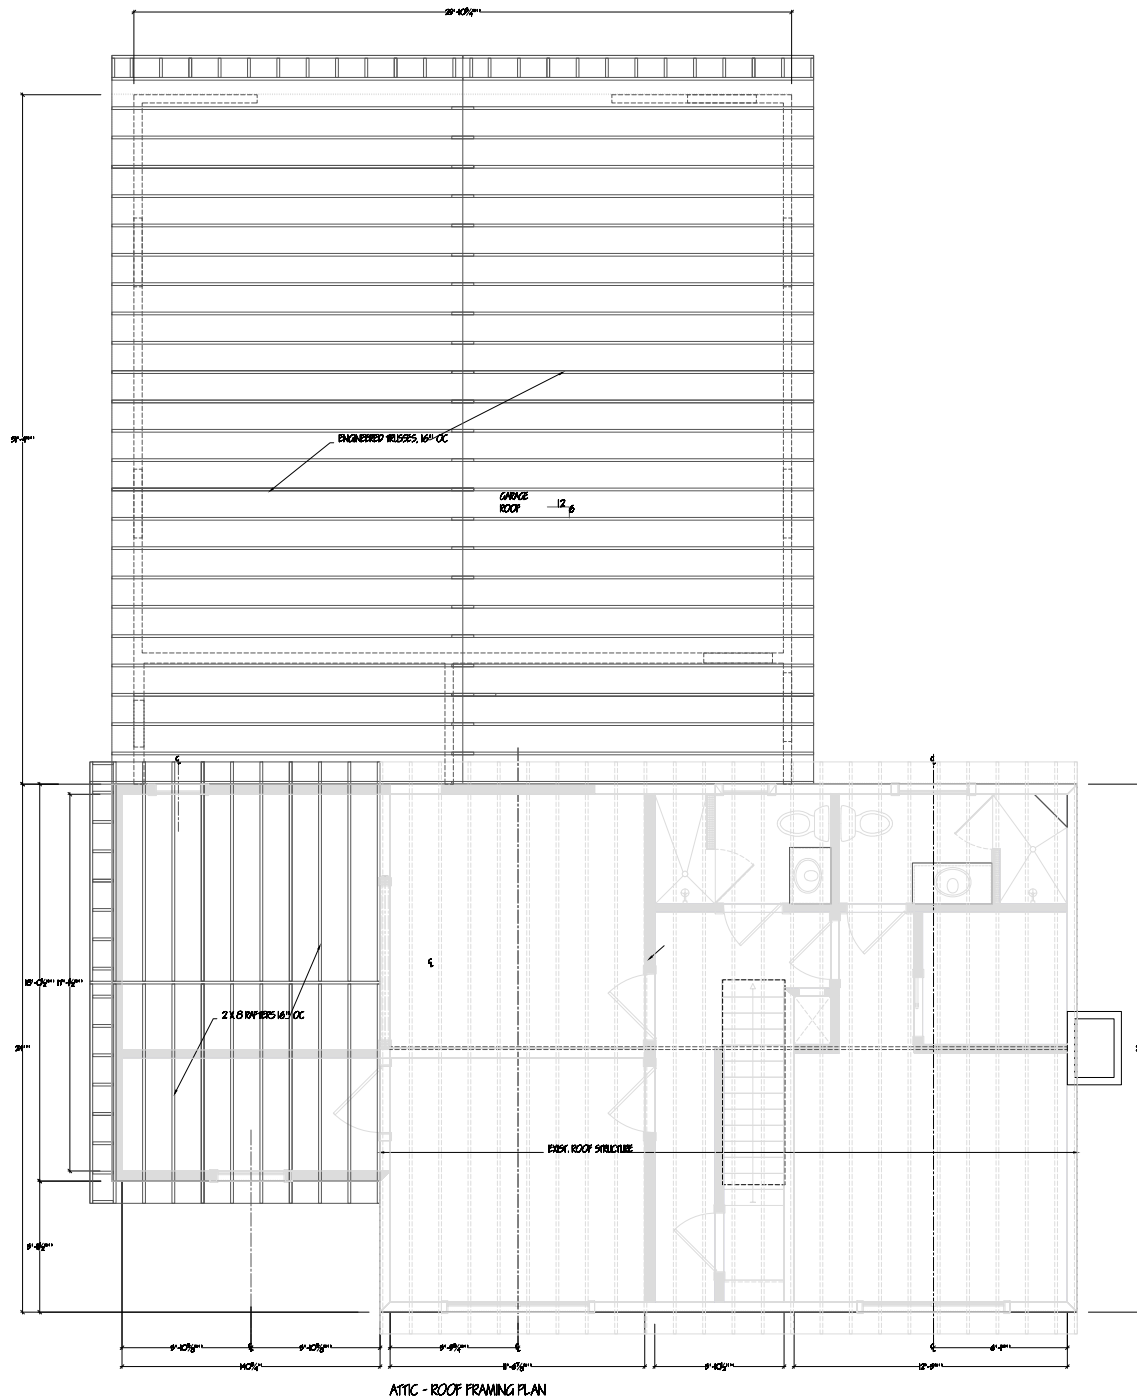

ATTIC - ROOF FRAMING PLAN

BOUNDARYLESS LIVING LLC  
5101 CALEDONIA ROAD  
RICHMOND, VA 23225

Copyright ©HN, INC.  
All reproduction and intellectual  
property rights reserved

1012 WA9TH STREET  
1012 WA9TH STREET  
RICHMOND, VA 23225

All reproduction + Intellectual property rights reserved

Drawn By: DHR  
Scale: 1/4"=1'  
Date: 11/23/20  
Revised dsk2/7/20, 12/8/20, 1/5/  
1/15/21, 1/30/21

2/23/21, 4/2/21  
PAGE 7

Reviewed per the 2015 Virginia Residential  
Code. The code can be read at the link below.  
<https://codes.iccsafe.org/content/VRC2015>

**Building Permit - Approved Construction Documents**  
Under general authority of the Building Code, this approved set of construction documents shall  
be used on the job site at all times and shall not be altered without approval from the Building  
Official. This permit does not approve any Electrical, Mechanical or Plumbing work. This approval  
does not relieve the builder from complying with manufacturers instructions, Virginia Building  
Statewide Building Code and City of Richmond regulations whether noted, implied or omitted.  
Plans: 20210407-1012-W-498-Sk-GLDR 087614-2021 04/26/2021 7:38:02  
AM

FINAL - DHR, 9/29/21

Field verify all  
dimensions and  
conditions, and obtain  
licensed engineer  
approval, prior to  
starting work and/or  
ordering materials

BOUNDARYLESS LIVING, LLC  
5101 CALEDONIA DRIVE  
RICHMOND, VA 23229  
804-784-5075

Copyright ©HN, INC.  
All reproduction and intellectual  
property rights reserved

1012 W49TH ST  
1012 W49TH ST  
RICHMOND, VA 23225


All reproduction + intellectual property rights reserved

Drawn By: DHR  
Scale: 1/4"=1'-0"  
Date: 1/15/21  
Revised date/30/21

4/2/21  
PAGE 8

FINAL - DHR, 9/29/21

Field verify all  
dimensions and  
conditions, and obtain  
licensed engineer  
approval, prior to  
starting work and/or  
ordering materials

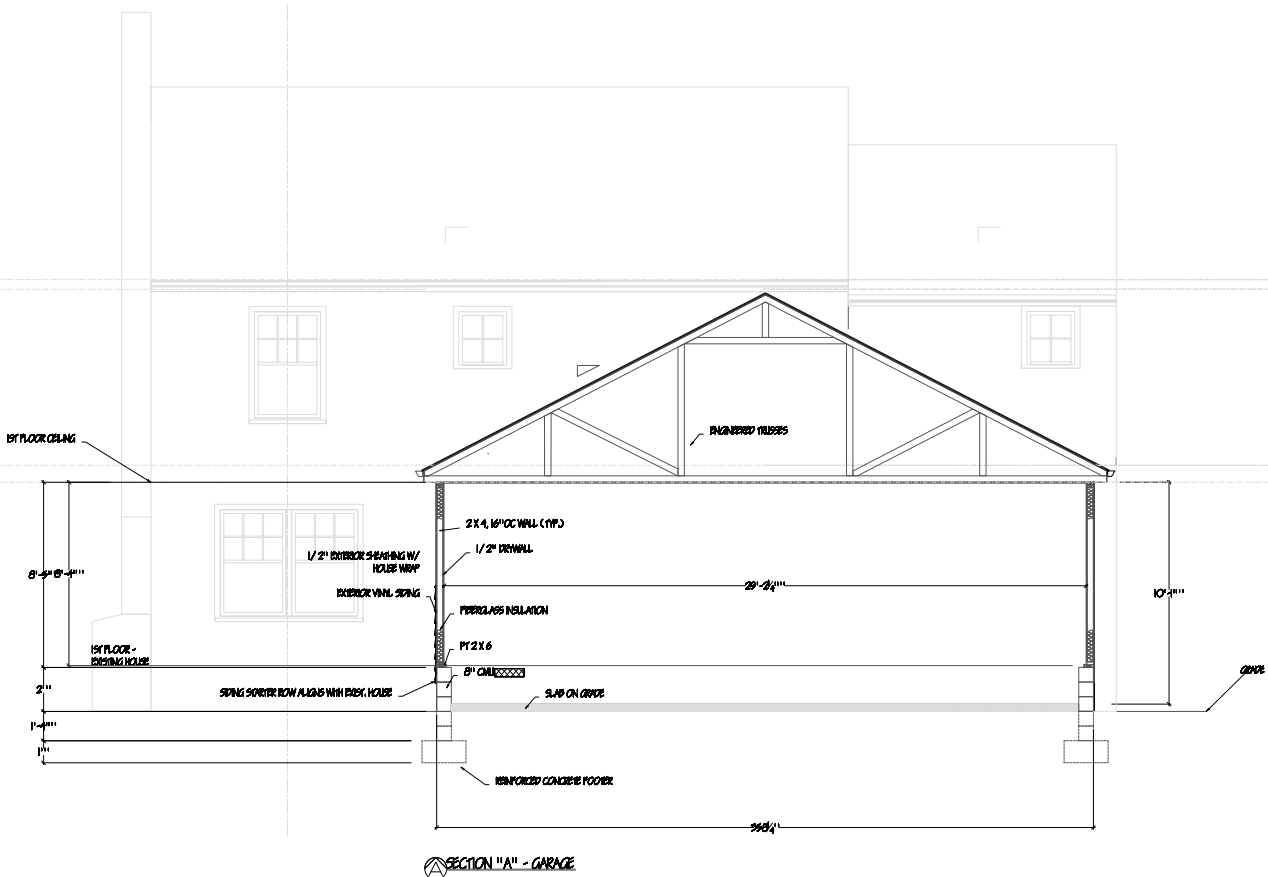


Reviewed per the 2015 Virginia Residential  
Code. The code can be read at the link below.  
<https://codes.iccsafe.org/content/VRC2015>

Building Permit - Approved Construction Documents  
Under general authority of the Building Code, this approved set of construction documents shall  
be kept on the job site at all times and shall not be altered without approval from the Building  
Official. This permit does not approve any electrical, mechanical or plumbing work. This approval  
does not relieve the builder from complying with manufacturer instructions, Virginia Uniform  
Statewide Building Code and City of Richmond regulations whether noted, implied or omitted.  
Plans: 20210407-1012-W-400-SL-8LDR-087614-2021 04/26/2021 7:38:08  
AM

**Building Permit - Approved Construction Documents**  
Under general authority of the Building Code, this approved set of construction documents shall be kept on the job site at all times and shall not be altered without approval from the Building Official. This permit does not approve any Electrical, Mechanical or Plumbing work. This approval does not relieve the builder from complying with all manufacturer's instructions, Virginia Uniform Statewide Building Code and City of Richmond regulations whether noted, implied or omitted.  
Plans-20210407-1012-W-49th-St-BLDR-087614-2021 04/26/2021 7:38:17  
AM

Copyright ©HN,INC.  
All reproduction and intellectual  
property rights reserved


All reproduction + intellectual property rights reserved

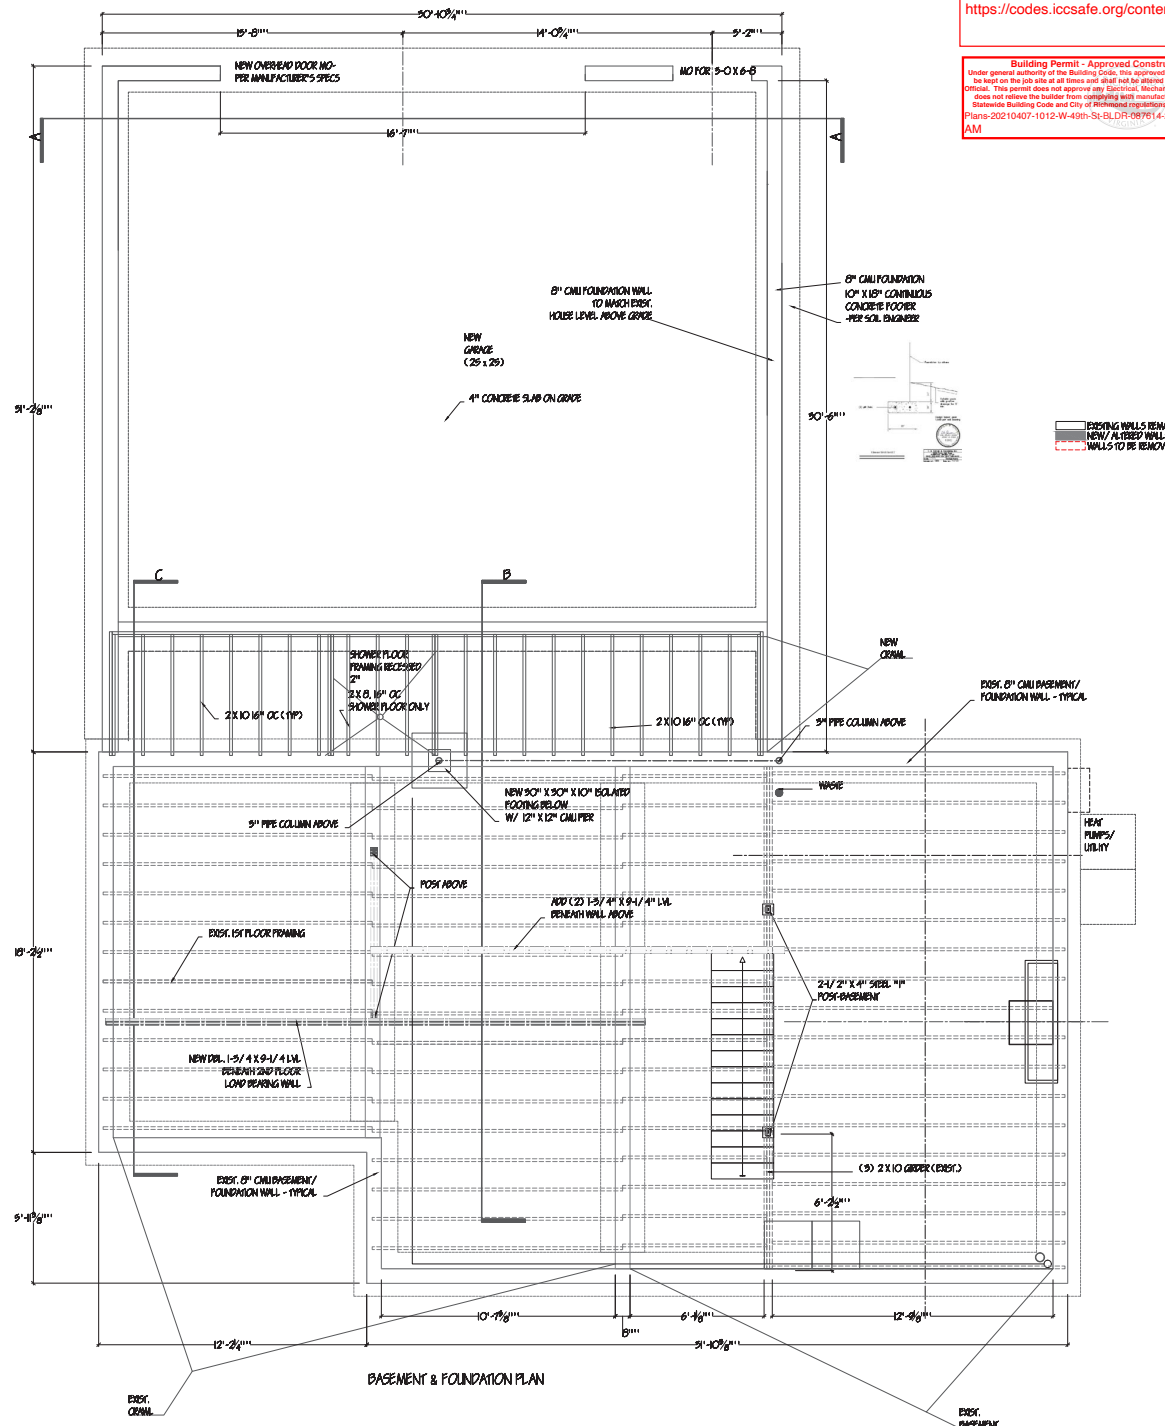

Field verify all dimensions and conditions, and obtain licensed engineer approval, prior to starting work and/or ordering materials

COMMONWEALTH OF VIRGINIA  
EVERETT H. MISH  
LICENSE NO. 21210  
PROFESSIONAL ENGINEER

Everett H. Mish, P.E.  
Mish, P.E.  
Digitally signed by Everett H. Mish, P.E.  
DN: cn=Everett H. Mish, P.E., o=Mish,  
ou=Engineering Group, c=US,  
email=everett.h.mish@comcast.com, c=US  
Date: 2011.02.27 16:34:33 -0500

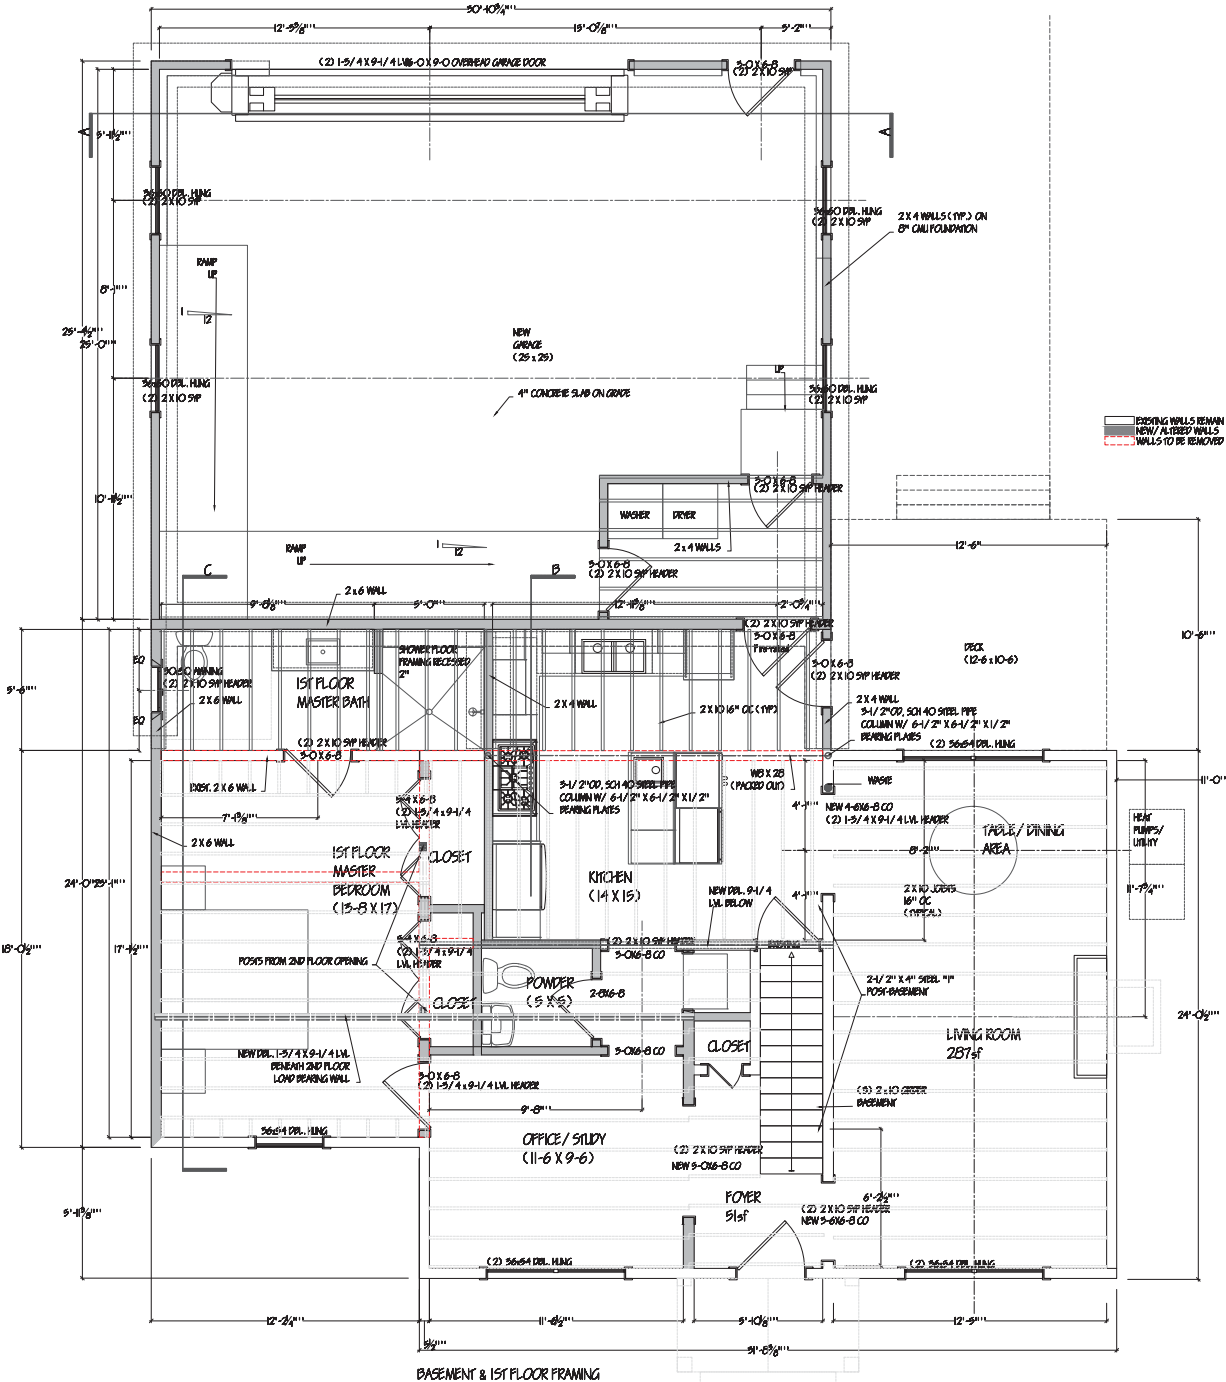

BASEMENT & 1ST FLOOR FRAMING

Structural Specification of Planned New LVL & Steel Headers, Beams & Supporting Framing by:

MISH ENGINEERING CONCEPTS, P.L.C.  
P.O. Box 262  
Manakin Sabot, VA 23103

Phone: (804) 285-3346

MEC STRUCTURAL NOTES:

1) Based on measurements and information obtained during 1/26/2021 site visit and that contained in this drawing.

2) Not all common-practice shoring and construction details included; and changes may be required due to as-constructed framing conditions not known at this time. Please contact engineer at (804) 285-3346 for additional information and on-site review.

3) Pre-construction meeting with contractor to review framing, shoring and other structural details is recommended.

COMMONWEALTH OF VIRGINIA  
EVERETT H. MISH  
LICENSE NO. 21210  
Everett H. Mish, P.E.  
Mish, P.E.

Building Permit - Approved Construction Documents  
Under general authority of the Building Code, this approved set of construction documents shall be kept on the job site at all times and shall not be altered without approval from the Building Official. This permit does not approve any Electrical, Mechanical or Plumbing work. This approval does not relieve the builder from complying with manufacturer instructions, Virginia Uniform Statewide Building Code and City of Richmond regulations whether noted, implied or omitted.  
Plans-20210407-1012-W-400-SR-BLDR-0876(4-2021) 04/26/2021 7:28:29 AM

Reviewed per the 2015 Virginia Residential Code. The code can be read at the link below.  
<https://codes.iccsafe.org/content/VRC2015>

Drawn By: DHR  
Scale: 1/4"=1'  
Date: 11/23/20  
Revised date: 10/20, 12/8/20, 12/15/21, 1/26/21, 1/29/21, 1/30/21, 2/20/21, 2/23/21  
PAGE 5

FINAL - DHR, 9/29/21  
Field verify all dimensions and conditions, and obtain licensed engineer approval, prior to starting work and/or ordering materials

**Building Permit - Approved Construction Documents**  
Under general authority of the Building Code, this approved set of construction documents shall be kept on the job site at all times and shall not be altered without approval from the Building Official. This permit does not approve any Electrical, Mechanical or Plumbing work. This approval does not relieve the builder from complying with manufacturer instructions, Virginia Uniform Building Code and City of Richmond regulations, whether noted, implied or omitted.

 
 
Plans-20210407-1012-W-49th-St-BLDR-087614-2021 04/26/2021 7:38:35  
AM

Copyright ©HN, INC.  
All reproduction and intellectual  
property rights reserved

1012 W49TH STREET  
1012 W49TH STREET  
RICHMOND, VA 23225

---

All reproduction + intellectual property rights reserved



PAGE 1

Field verify all dimensions and conditions, and obtain licensed engineer approval, prior to starting work and/or ordering materials



Reviewed per the 2015 Virginia Residential Code. The code can be read at the link below.  
<https://codes.iccsafe.org/content/VRC2015>

**Building Permit - Approved Construction Documents**  
 Under general authority of the Building Code, this approved set of construction documents shall be kept on the job site at all times and shall not be altered without approval from the Building Official. This permit does not approve any Electrical, Mechanical or Plumbing work. This approval does not relieve the builder from complying with manufacturer instructions, Virginia Uniform Statewide Building Code and City of Richmond regulations whether noted, implied or omitted.  
 Plans: 20210407-1012-W-49th-St-BLDR-087614-2021 04/26/2021 7:38:47 AM  
 JLE

**BOUNDARLESS LIVING, LLC**  
 5101 CALEDONIA ROAD  
 RICHMOND, VA 23225

Copyright ©HN, INC.  
 All reproduction and intellectual property rights reserved

1012 W 49TH STREET  
 1012 W 49TH STREET  
 RICHMOND, VA 23225


All reproduction + Intellectual property rights reserved

Drawn By: DHR  
 Scale: 1/4"=1'-0"  
 Date: 11/23/2020  
 Revised date: 9/30/21


PAGE 2

FINAL - DHR, 9/29/21

Field verify all dimensions and conditions, and obtain licensed engineer approval, prior to starting work and/or ordering materials

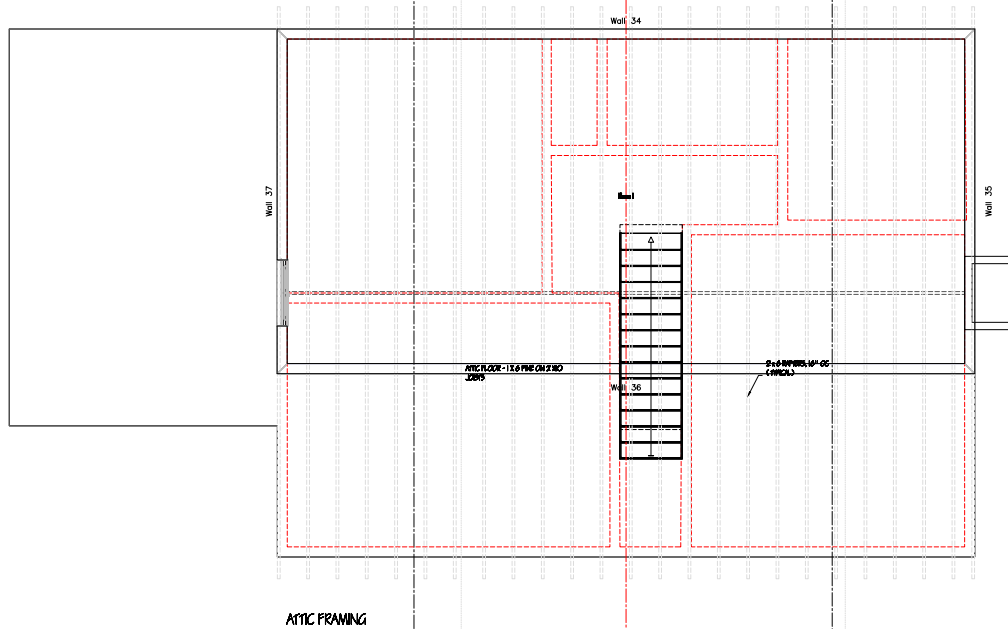

ATM FRAMING

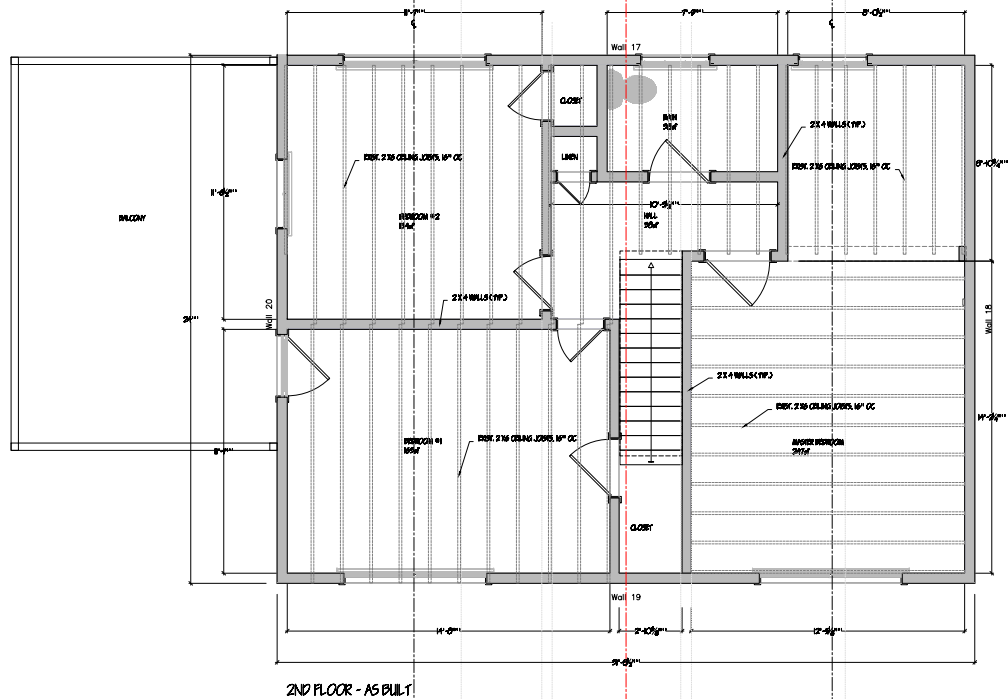

2ND FLOOR - AS BUILT