From: PDR Land Use Admin

To: Oliver, Alyson E. - PDR; Watson, David F. - PDR

Subject: FW: N 35th Street home owner comments to Ord.No. 2022-262

Date: Friday, September 30, 2022 2:21:25 PM

Attachments: Bacon Senior Living - Neighbor Plan Comments.pdf

800 block N 35th St- home owner comments.pdf

From: Lothar Pausewang [mailto:LPausewang@glaveandholmes.com]

Sent: Friday, September 30, 2022 1:09 PM

To: PDR Land Use Admin <PDRLandUseAdmin@rva.gov> **Cc:** Sebastian Meussling <SMeussling@glaveandholmes.com>

Subject: N 35th Street home owner comments to Ord.No. 2022-262

CAUTION: This message is from an external sender - Do not open attachments or click links unless you recognize the sender's address and know the content is safe.

To whom it might concern,

Attached is the site plan of 815 N 35th Street with comments and signed comment letter from homeowners of the 800 block of N 35th Street regarding Ord. No. 2022-262. Sebastian Meusling (810 N35th St) and myself (812 N35th St) will attend Monday's meetings. Please forward both documents to the committee.

Kind Regards Lothar Pauseang

Lothar Pausewang
LEED® Accredited Professional

Glavé & Holmes Architecture

elevating the human spirit.

2101 East Main Street Richmond, Virginia 23223

t: (804) 649-9303

w: www.glaveandholmes.com

CONFIDENTIALITY NOTICE: This E-mail and any attachments are private and are intended only for the use of the addressee, and may contain privileged and/or confidential information. If you are not the intended recipient, you are hereby notified that the use, dissemination, distribution, or copying of this E-mail and/or the attachments is strictly prohibited.


Comments of Homeowners on the 800 block of N 35th Street Richmond, VA 23223

Meeting to amend and reordain Ord. No. 95-152-151, Ord. No. 97-222-236, Ord. No. 98-335-99-20. The following are comments of the homeowners and residents living adjacent to the property.

- Preserve lawn area on 35th street. Provide green space between sidewalk and parking. Provide setback for parking from sidewalk.
- The proposed project is very condensed occupying large portions of the available site with buildings and parking. Consider creating an intimate Garden/Park for the senior residents instead of subdividing the 2 lots for proposed single family housing. For some of the senior residents this might be the only option to spent time outside during the years they are living here.
- Refer to markup on drawing A1.00 for additional comments dated September 28, 2022.



Printed Name	Address	Signature	11 1
Olivia Moseley	800 N 35th St	Olivia	Moseley
Ryan Gunn	804 N 35th St	All I	9/38/22
Jahovie Whiting	806 N 35th St	Lohnnie	When 9/30/22
Andria Storeman	808 N 35th St	0=	9/128/22
SEBASTIAN MEUSSLIN	6 810 N 35th St	Clyh-	09/23/22
LOTHAR PAUSEWANG	812 N 35th St	Total	£ 09.28.22
David E Sachs	814 N 35th St	Don't E	July 9/28/22
1	816 N 35th St	******************	
1	822 N 35th St		
	824 N 35th St	-	
	926 N 25+h C+		

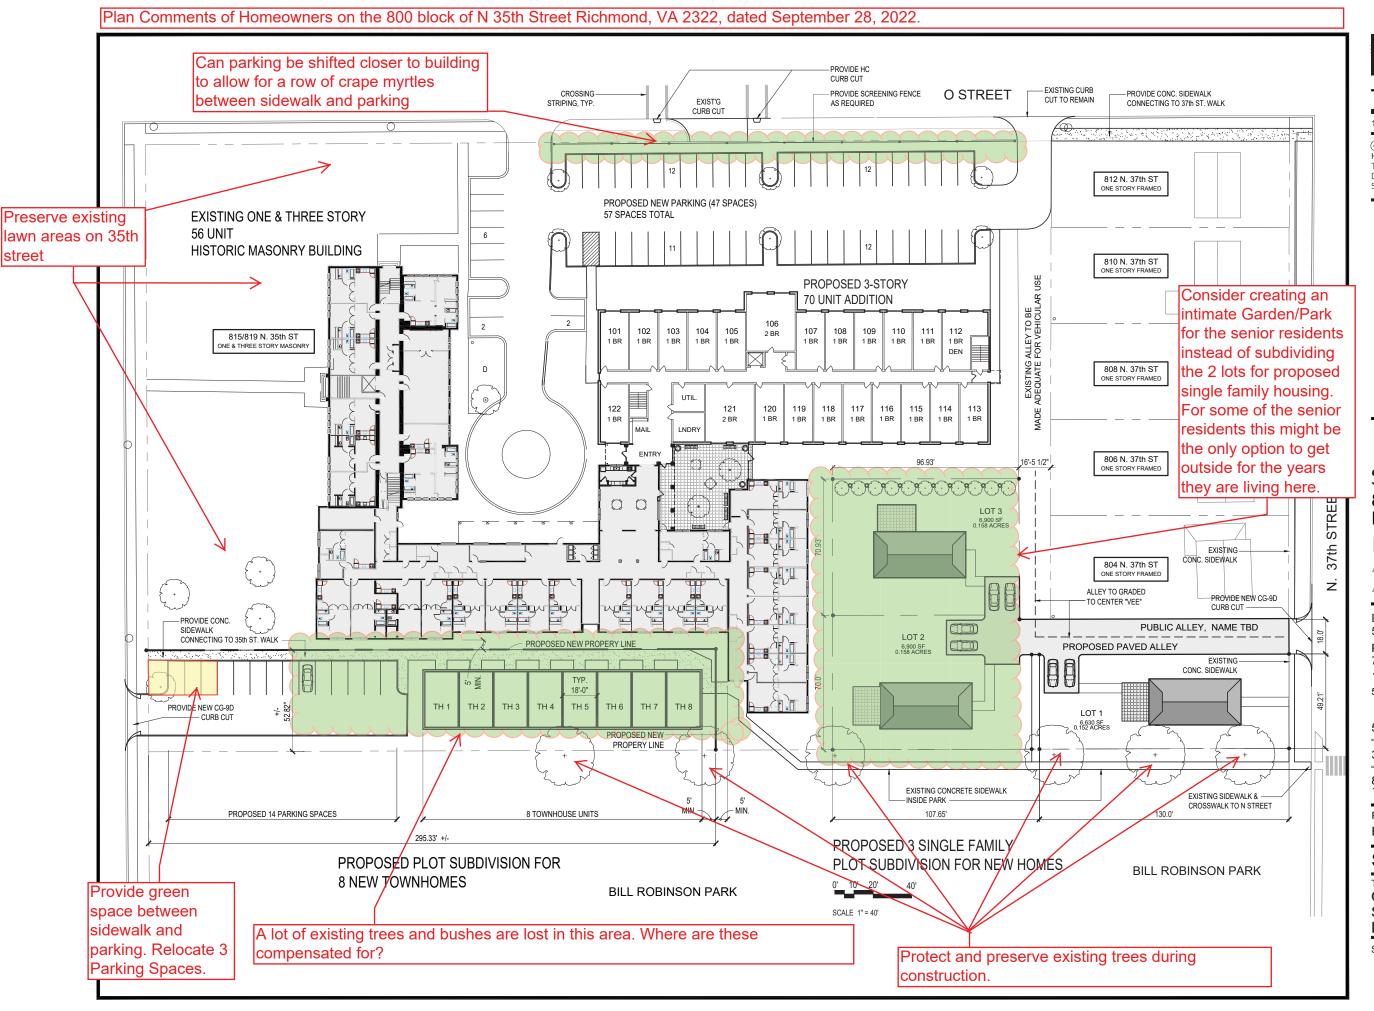



SWA ARCHITECTS-VA, INC. MATERIAL INCLUDED HEREON IS COVERED BY COPYRIGHT, USE OF THIS WORK IN WHOLE OR IN PART IS FORBID-DEN WITHOUT THE EXPRESSED WRITTEN CON-SENT OF SWA ARCHITECTS.

Senior Housing 815 N. 35th STREET Richmond, VA 23223

Proposed Additions & Alterations

EXISTING STRUCTURE 56 UNITS

PROPOSED ADDITION 70 UNITS

126 UNITS TOTAL

59 1 BEDROOM UNITS 6 2 BEDROOM UNITS 5 1 BEDROOM + DEN UNITS

57 PARKING SPACES PROVIDED

3 SINGLE FAMILY LOTS

8 TOWNHOMES with 14 PARKING SPACES

PROJECT MGR:

05 / 18 / 22

DATE:

SPECIAL USE PERMIT

Concept Site Plan with Single Family Attached Lots

SHEET No.